


Map No. _____ Sec. 16 Twp. 28 R. 4
Well No. 14 Cunningham Farm
Cumpride Company

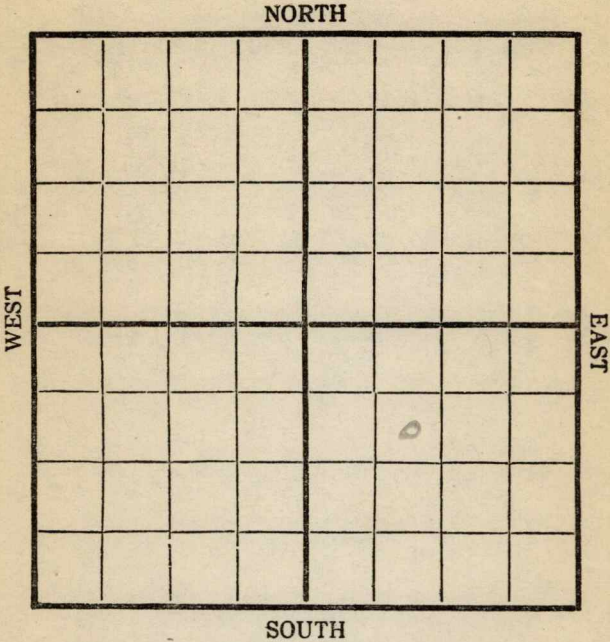

Location _____	RECORD
Rig Up _____	Cased _____ in. _____ Ft.
Drilling and remarks	Sand _____
	Gas _____
	Oil _____
	Total Depth _____
	PRODUCTION
	1st 24 hrs. Nat. _____
	1st 24 hrs. after shot _____
	Gas _____ Cu. Ft.
	Dry Hole _____
	Abandoned _____

First Report


Date 6/12, 1917, Cumpride Scout

Map No. _____ Sec. 16 Twp. 28 R. 4
 Well No. 140 Cunningham Farm
Cunningham Company

NORTH

WEST

EAST

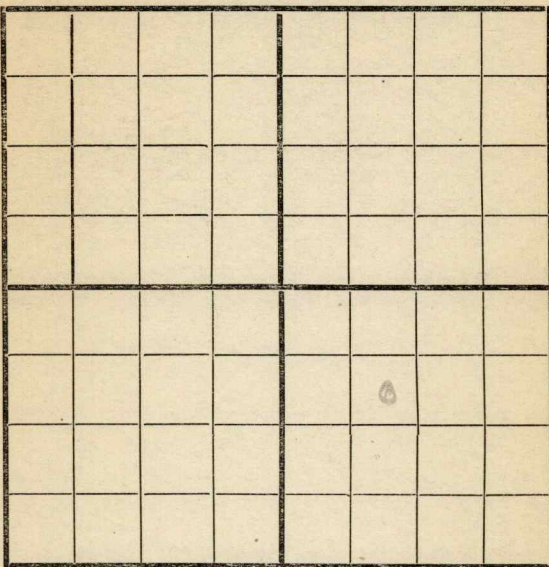

SOUTH

Location _____
 Rig Up _____
 Drilling and remarks

300

RECORD

Cased _____ in. _____ Ft.
 Sand _____
 Gas _____
 Oil _____
 Total Depth _____

PRODUCTION


1st 24 hrs. Nat. _____
 1st 24 hrs. after shot _____
 Gas _____ Cu. F
 Dry Hole _____
 Abandoned _____

Date

6/20, 1917 C. C. C.

Map No. _____ Sec. 16 Twp. 28 R. 4
 Well No. 14 Cunningham Farm
Engine Company

NORTH

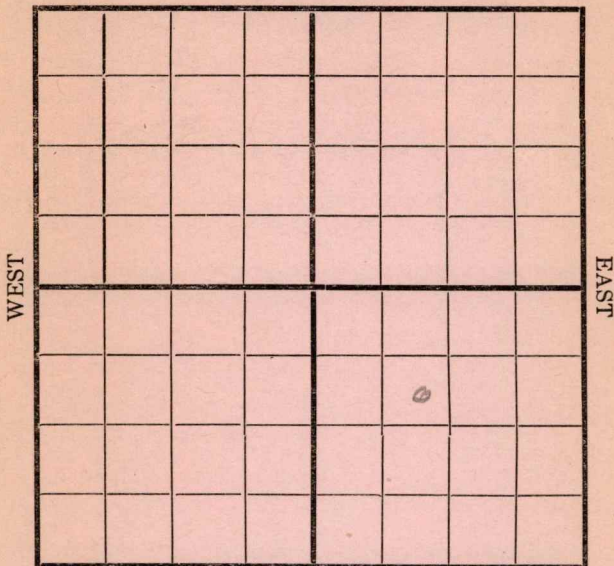

SOUTH

Location _____
 Rig Up _____
 Drilling and remarks

850

RECORD

Cased _____ in. _____ Ft.
 Sand _____
 Gas _____
 Oil _____
 Total Depth _____

PRODUCTION

1st 24 hrs. Nat. _____
 1st 24 hrs. after shot _____
 Gas _____ Cu. Ft.
 Dry Hole _____
 Abandoned _____


Date

6/27 1917 Carly Scout

Map No. _____ Sec. 16 Twp. 28 R. 4Well No. 14 Cunningham FarmEngine Company

NORTH

WEST

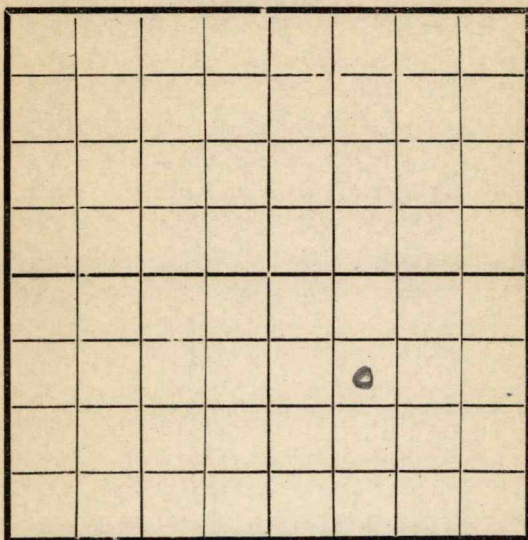

EAST

SOUTH

Location _____

Rig Up _____

Drilling and remarks

1420'

RECORD

Cased _____ in. _____ Ft.

Sand _____

Gas _____

Oil _____

Total Depth _____

PRODUCTION

1st 24 hrs. Nat. _____

1st 24 hrs. after shot _____

Gas _____ Cu. Ft.

Dry Hole _____

Abandoned _____


Date

7/6, 1917 Candy Scout

Map No. _____ Sec. 16 Twp. 38 R. 4Well No. 140 Farm _____Engine Company _____

NORTH

WEST

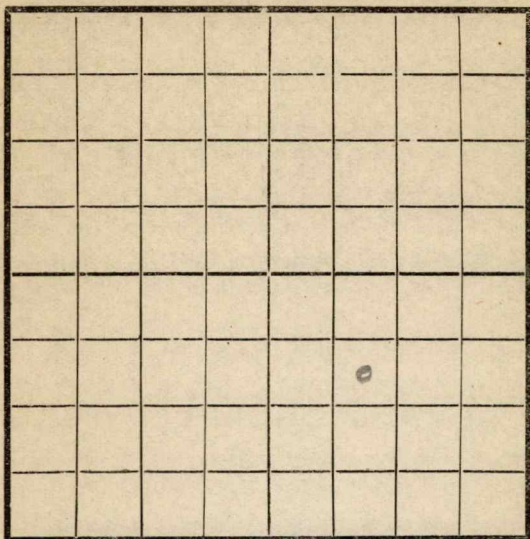

EAST

SOUTH

Location _____

Rig Up _____

Drilling and remarks

1740'

RECORD

Cased _____ in. _____ Ft.

Sand _____

Gas _____

Oil _____

Total Depth _____

PRODUCTION

1st 24 hrs. Nat. _____

1st 24 hrs. after shot _____

Gas _____ Cu. Ft.

Dry Hole _____


Abandoned _____

Date

7/12, 1917 Carley Scout

Map No. _____ Sec. 16 Twp. 28 R. 4Well No. 14 Emminger FarmEmminger Company

NORTH

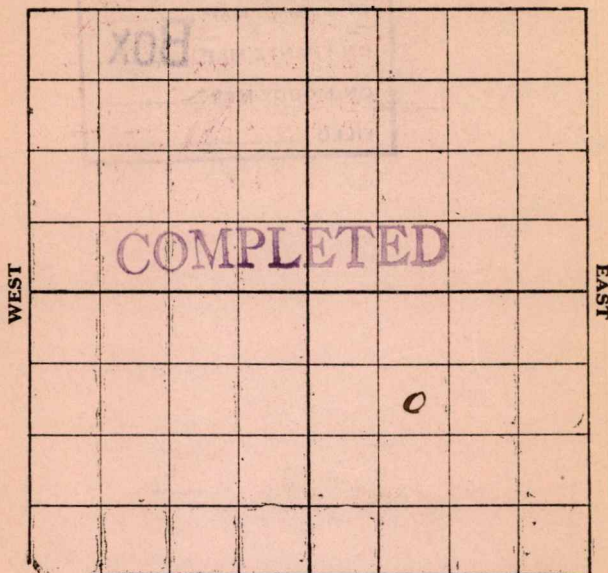

SOUTH

RECORD

Location _____

Rig up _____

Drilling and Remarks:

Est at
85 Bbls

Cased _____ in. _____ Ft.

Sand 2512-2518

Gas _____

Oil _____

Total Depth _____

PRODUCTION

1st 24 hrs. Nat. _____

1st 24 hrs. after shot _____

Gas _____ Cu. Ft.

Dry Hole _____

Abandoned _____

Date

7/27, 1917, Carbide Scout