


FORM 51 25M 3-49 PETROL Cowley

Section 20 Township 34 Range 3E

Well No. #2 E. W. Shurtz "B"

Company Goldenstern & Steiper

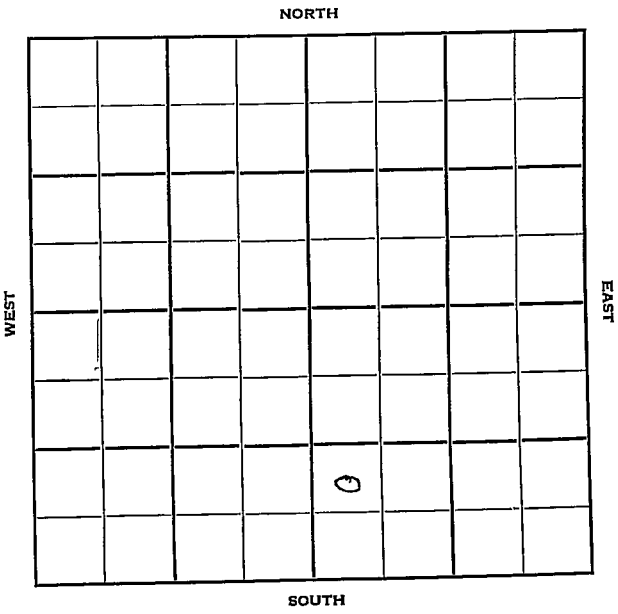

Sec. 20 Twp. 34 R. 3 E

Well No. # 2 E. W. Shurtz "B" Farm

Goldenstern & Stoiper Company

Springer & Harper Contractor

Gibson Pool


Ft. from N. Line

990 Ft. from S. Line

Ft. from E. Line

330 Ft. from W. Line

NW SW SE

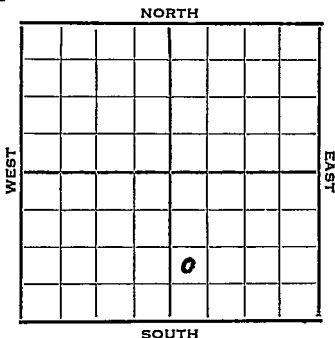

1952 Elev. 1141' REPORT

11/5 Spud 11-1-52
8" @ 101
Drlg. 161'

11/26 Spud 11-1-52
D&A
TD 3398'
8" @ 101
KC 2855, Oswego 3020, Miss 3393
TD 3398
D&A

ABANDONED

