
FORM 51 25M 8-50 WESTERN Rice KANSAS

Section 2 Township 18 Range 8 W

Well No. # 5 Gray

Company Francis Raymond

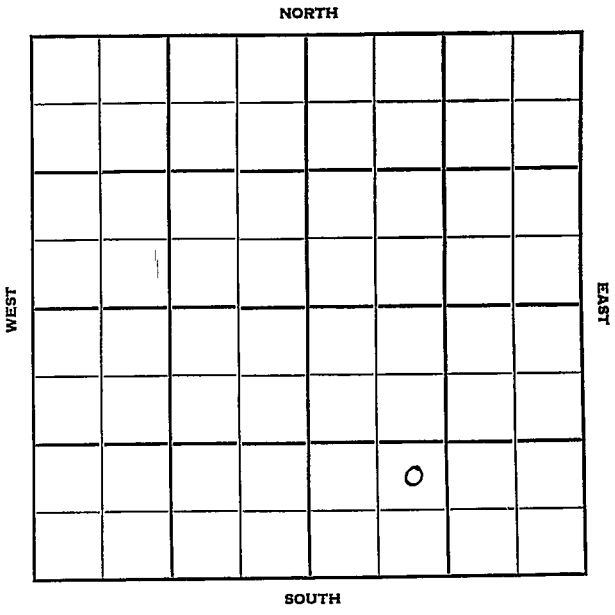

FORM 252-B
10M 11-50 PETROL

KANSAS

Rice

Sec. 2 Twp. 18 R. 8W

Well No. #5 Gray Farm

Francis Raymond Company

Contractor

Geneseo Pool


Ft. from N. Line

990' Ft. from S. Line

Ft. from E. Line

990' Ft. from W. Line

NE SW SE

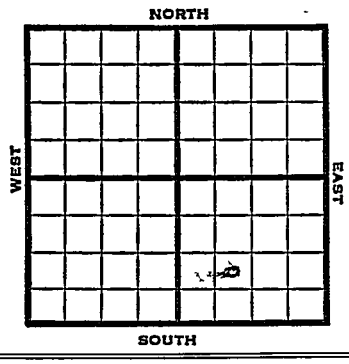

1951	Elev. 1766' REPORT
3/28	Spud 3-26-51 Drlg.
4/11	Spud 3-26-51 D & A TD 3320' 10" @ 330 Heeb 2694' Br. lime 2826' Lans. 2851' Cong 3224' DST 3224-35 open ½ hr. rec 5' mud DST 3229-52 open 1¼ hr. rec 132' OCM DST 3252-65 open 1¼ hr. rec 6' mud TD 3320' D & A **ABANDONED**

FORM 275 FOR SALE BY KANSAS BLUE PRINT CO.


County Rice State Kansas

Sec. 2 (Blk. Twp.) 18 (Sur. Rge.) 8W Map No.

Operator Francis Raymond

Well No. 5 Farm Gray

Elev. Location NE SW SE

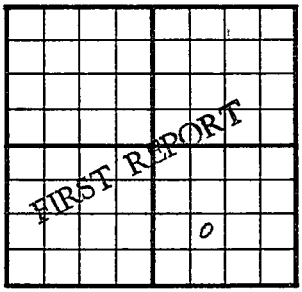

990 Ft. From S Line SE

990 Ft. From W Line Quarter

1st. Report MAR 2 8 1951

Completion

Remarks

Spudding Date 3-26-51

Drlg. Data Geneseo Pool

drlg.

J. E. TYRA

FORM 275 FOR SALE BY KANSAS BLUE PRINT CO.


County Rice State Kansas

Sec. 2 (Blk. Twp.) 18 (Sur. Rge.) 8W Map No.

Operator Francis Raymond

Well No. 5 Farm Gray

Elev. 1766 Location NE SW SE

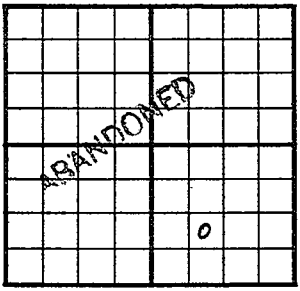

990 Ft. From S Line SE

990 Ft. From W Line Quarter

1st. Report

Completion APR 11 1951

Remarks Geneseo Pool

Spudding Date 3-26-51

Drlg. Data D & A TD 3320

10" @ 330 Heeb. 2694 Br. lime 2826

Lans. 2851 Cong. 3224 DST 3224-35

open ½ hr. Rec. 5' mud DST 3229-52

open 1¼ hr. Rec. 132' ocm DST 3252-65

open 1¼ hr. Rec. 6' mud TD 3320

D & A

J. E. TYRA