

Butler


FORM 51

KANSAS  
4E

Section 16 Township 28 Range 4E

Well No. #5 Cunningham

Company Morris Sitrin

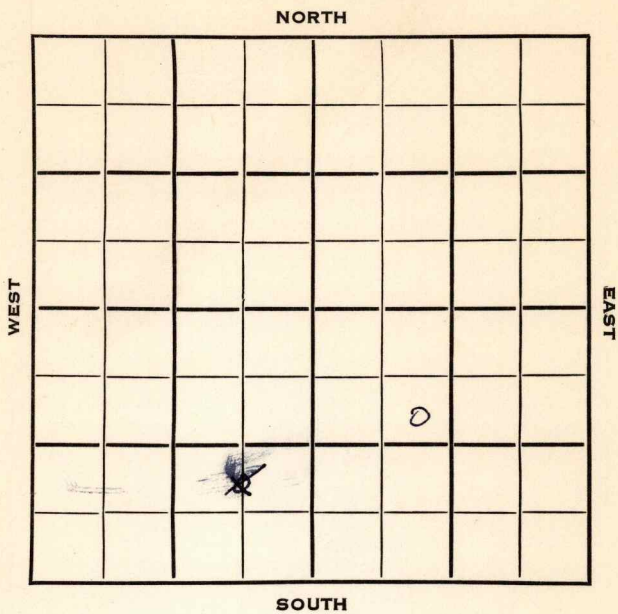

Pratt KANSAS

SEC.	TWP.	R.
16	28	4E ✓

WELL NO.

5 Cunningham

FARM

COMPANY

Morris Sitrin

CONTRACTOR

H & M Drlg.


Augusta Pool

~~1100~~ Ft. from N. Line

~~990~~ Ft. from S. Line

~~660~~ Ft. from E. Line

850 Ft. from W. Line

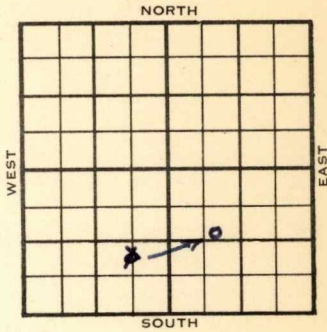

SE NW SE  
~~ENL SE SW~~

1954	ELEVATION	REPORT
	1206'	

2/24  
 3/17

Location

Spud 2-23-54 D & A TD 2555  
 8" @ 65 KC 2019 Simp. 2484  
 Arb. 2503 TD 2555 5" @ 2554  
 CO to 2550 39/2520-40 7 BOPD 200  
 BW SP 2503 12/2476-80  
 D & A

**ABANDONED**



Kansas

Map No. \_\_\_\_\_ Sec. 16 Twp. 28 R. 4E

Well No. 5 Cunningham

Morris Sitrin Company

**CORRECTION**

Contractor

SE NW SE

SECTION PLAT

1100 Ft. from N. Line

\_\_\_\_\_ Ft. from S. Line

\_\_\_\_\_ Ft. from E. Line

850 Ft. from W. Line


Butler County

Location \_\_\_\_\_

Rig up \_\_\_\_\_

Drilling and Remarks:

MAR 3 1954  
 Reported  
 C N L SE SW

RECORD

Cased \_\_\_\_\_ in., \_\_\_\_\_ ft.

Sand \_\_\_\_\_

Gas \_\_\_\_\_

Oil \_\_\_\_\_

Total Depth \_\_\_\_\_

PRODUCTION

1st 24 hrs. Nat. \_\_\_\_\_

1st 24 hrs. after shot \_\_\_\_\_

Gas \_\_\_\_\_ Cu. Ft.

Dry Hole \_\_\_\_\_

Abandoned \_\_\_\_\_

Date

MAR 3 1954 19

J. G. McGEHEE

Scout

