


Map No. _____ Sec. 16 Twp. 28 R. 4
 Well No. 8 Cunningham Farm _____
Empire Company _____

NORTH

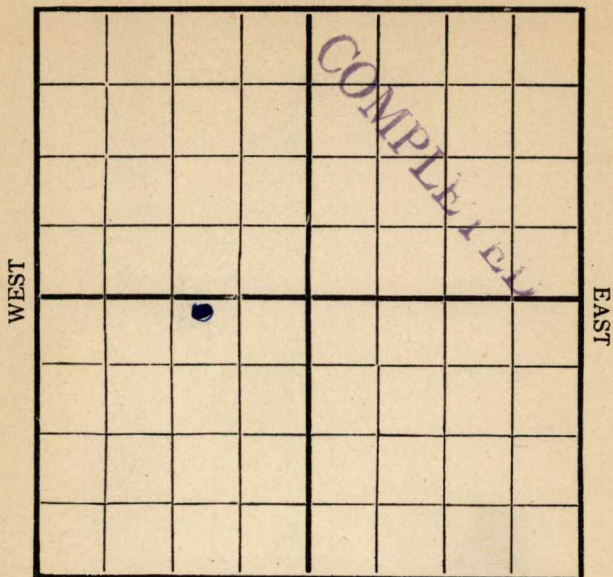

SOUTH

Location (6/2)

Drilling Remarks:

2472 - 2510
175666

Rig Up _____

Drilling Remarks:

RECORD

Cased _____ in. _____ Ft.
 Sand _____
 Gas _____
 Oil _____
 Total Depth _____

PRODUCTION

1st 24 hrs. Nat. _____
 1st 24 hrs. after shot _____
 Gas _____ Cu. Ft.
 Dry Hole _____
 Abandoned _____

Map No. _____ Sec. 16 Twp. 28 R. 4
 Well No. 8 _____ Farm _____
Campbell _____ Company _____

NORTH

WEST

EAST

SOUTH

Location ✓ _____
 Rig Up _____
 Drilling and remarks _____

RECORD

Cased _____ in. _____ Ft.
 Sand _____
 Gas _____
 Oil _____
 Total Depth _____

PRODUCTION

1st 24 hrs. Nat. _____
 1st 24 hrs. after shot _____
 Gas _____ Cu. Ft.
 Dry Hole _____
 Abandoned _____

Date

191 6

Scout


Map No. _____ Sec. 16 Twp. 28 R. 4Well No. 8 Farm _____

Company _____

NORTH

WEST

EAST

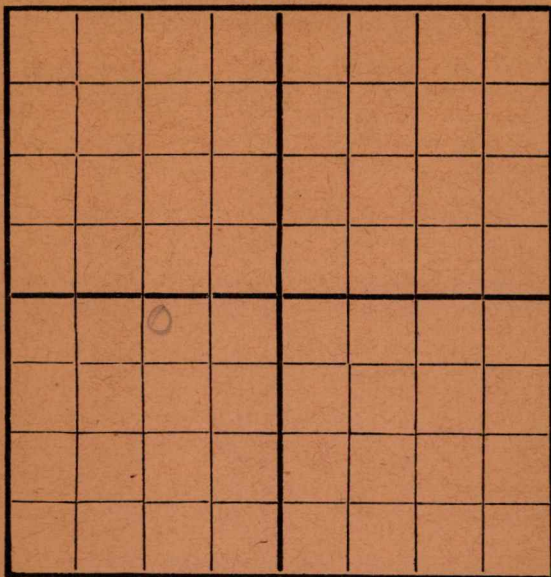

SOUTH

Location _____

Rig Up _____

Drilling and remarks

1590

RECORD

Cased _____ in. _____ Ft.

Sand _____

Gas _____

Oil _____

Total Depth _____

PRODUCTION

1st 24 hrs. Nat. _____

1st 24 hrs. after shot _____

Gas _____ Cu. Ft.

Dry Hole _____

Abandoned _____

Date


7/31, 1911 C. L. Lundy Scout

Map No. _____ Sec. 16 Twp. 28 R. 4
 Well No. 8 Cunningham Farm _____
Enterprise Company _____

NORTH

WEST

EAST

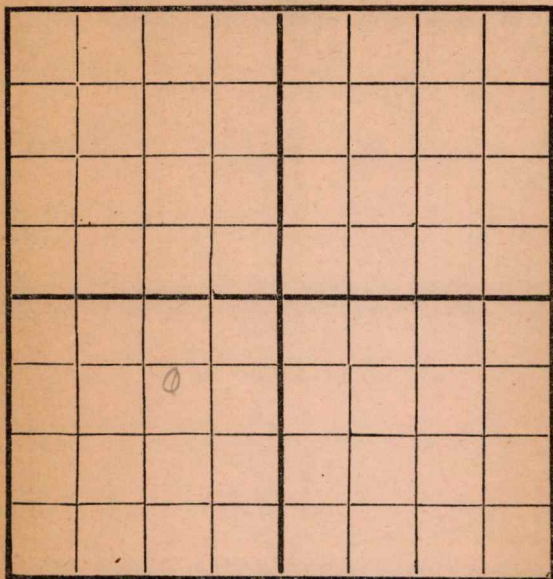

SOUTH

Location _____
 Rig Up _____
 Drilling and remarks _____

2120

RECORD

Cased _____ in. _____ Ft.
 Sand _____
 Gas _____
 Oil _____
 Total Depth _____

PRODUCTION

1st 24 hrs. Nat. _____
 1st 24 hrs. after shot _____
 Gas _____ Cu. Ft.
 Dry Hole _____
 Abandoned _____


Date

8/8/1916 Scout

Map No. _____ Sec. 16 Twp. 28 R. 4
 Well No. 8 Cunningham Farm
Campine Company

NORTH

WEST

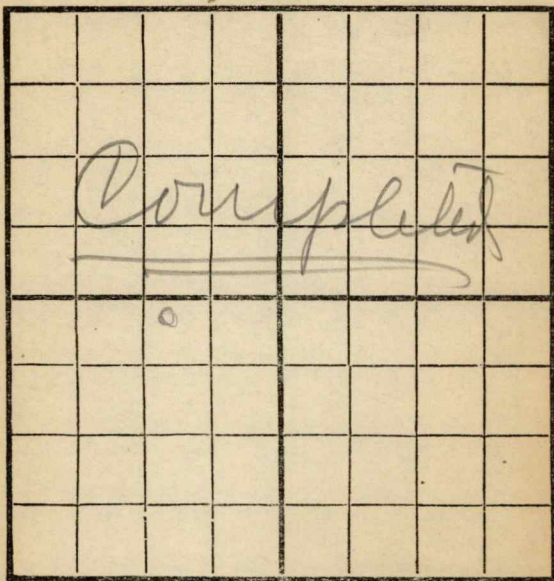

EAST

SOUTH

Location _____

Rig Up _____

Drilling and remarks

2472'On top of sand8718 good for 175 bbls

RECORD

Cased _____ in. _____ Ft.

Sand 2472-2510

Gas _____

Oil _____

Total Depth _____

PRODUCTION

1st 24 hrs. Nat. 175

First 24 hrs. after shot _____

Gas _____ Cu. Ft.

Dry Hole _____

Abandoned _____

Date

8/14, 1916 Scout