
FORM 51 25M 8-50 WESTERN Rice

KANSAS

Section 3 Township 18 Range 8W

Well No. #1 Dobrinski

Company Francis Raymond

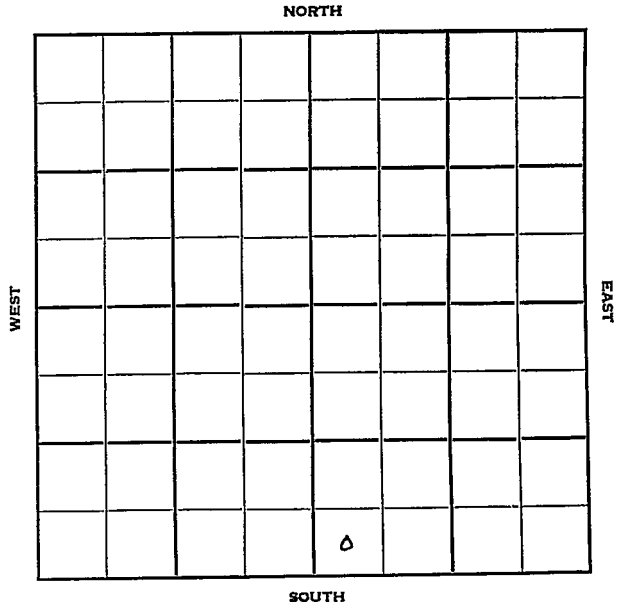

FORM 252-B
10M 10-50 'PETROL

Rice

KANSAS

Sec. 3 Twp. 18 R. 8W

Well No. #1 Dobrinski - Farm

Francis Raymond Company

Ash - Mur Contractor


____ Ft. from N. Line

330' Ft. from S. Line

____ Ft. from E. Line

330' Ft. from W. Line

SW SW SE

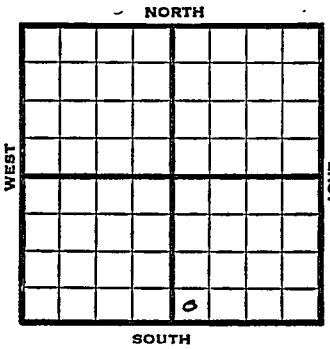

1951	Elev.1782' REPORT
11/21	RUR
1952 1/9	Spud 11-21-51 Oil Well TD 3254 8" @ 276 Heeb. 2710 Br lime 2831 KC 2955 Arb. 3245-49 5" @ 3247 TD 3254 S/98 boph P/70 boph Comp. 3000 bopd COMPLETED

FORM 275 FOR SALE BY KANSAS BLUE PRINT CO


County Rice State Kansas

Sec. 3 (Blk. Twp.) 18 (Sur. Rge.) 8W Map No.

Operator Francis Raymond

Well No. 1 Farm Dobrinski

Elev. Location SW SW SE

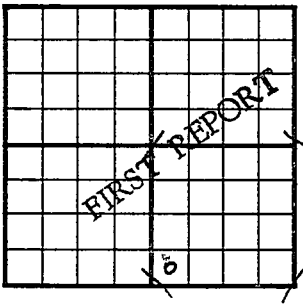

330 Ft. From S Line SE

330 Ft. From W Line Quarter

1st. Report NOV 21 1951

Completion

Remarks

Ash - Mur - Contr.

Spudding Date

Drlg. Data

R U R

J. E. TYRA

FORM 275 FOR SALE BY KANSAS BLUE PRINT CO.


County Rice State Kansas

Sec. 3 (Blk. Twp.) 18 (Sur. Rge.) 8W Map No.

Operator Francis Raymond

Well No. 1 Farm Dobrinski

Elev. 1782 Location SW SW SE

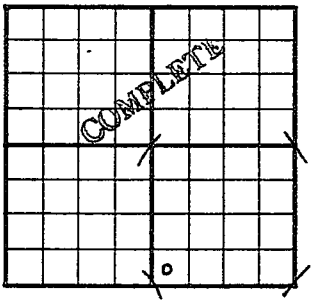

330 Ft. From S Line SE

330 Ft. From W Line Quarter

1st. Report

Completion JAN 9 1952

Remarks Edwards Pool

Ash - Mur - Contr.

Spudding Date 11-21-51

Drlg. Data Oil well TD 3254

8" @ 276 Heeb. 2710 Br. lime 2831

KC 2955 Arb. 3245-49 5" @ 3247

TD 3254 S/ 98 boph P/ 70 boph

Comp. 3000 bopd

J. E. TYRA