

KANSAS


FORM 51 5M PETROL

Cowley

Section 20 Township 34 Range 3E

Well No. #1 F.W. Schurtz (*Schurtz*)

Company D.T. Ingling

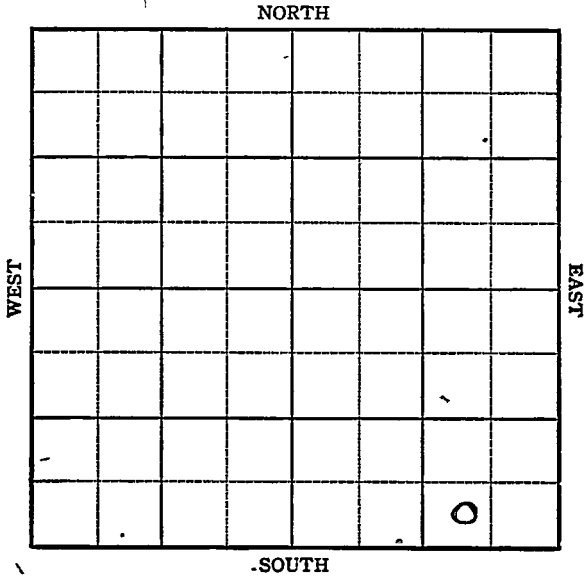

Sec. 20 Twp. 34 R. 3E

Well No. #1 E.W. Schurtz Farm

D.T. Ingling Company


Miscellaneous

 Ft. from N. Line

450 Ft. from S. Line

850 Ft. from E. Line

 Ft. from W. Line

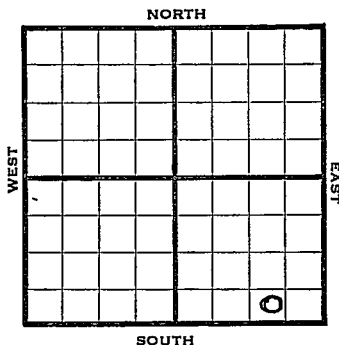

1944

REPORT

4/12 8" @ 108
 636'

4/19 3103 fsg.

4/26 Bart 3374-75 TD
 5" @ 3374
 Rust

5/3 "

5/10 TD 3393 1200' oil
 20 qts. 3381-91 CO

5/17 Swab 50 oil in 24 hrs.

5/24 5" @ 3374
 Bart 3374
 T^U 3393
 20 qts 3381-91
 Pump 50 Pot.
 Gravity 38

COMPLETED

Cowley

KANSAS

Map No. / Sec. 20 Twp. 34 R. 3E

Well No. 1 E. W. Schurtz

D. T. Ingling Company

FIRST REPORT

Contractor

SW SE SE

SECTION PLAT

_____ Ft. from N. Line

450 Ft. from S. Line

850 Ft. from E. Line

_____ Ft. from W. Line

Miscellaneous

Location _____

Rig up _____

Drilling and Remarks:

8" - 108

636

RECORD

Cased _____ in _____ ft.

Sand _____

Gas _____

Oil _____

Total Depth _____

PRODUCTION

1st 24 hrs. Nat. _____

1st 24 hrs. after shot _____

Gas _____ Cu. Ft.

Dry Hole _____

Abandoned _____

Date

APR 12 1944 19

S. J. LEWIS Scout

KANSAS

Pool Name Miscellaneous

Map No. 1 Sec. 20 Twp. 34 R. 3E

Well No. 1 E. W. Schurtz

D. T. Ingling Company

COMPLETED Contractor

SW SE SE

SECTION PLAT

			o

_____ Ft. from N. Line

450 Ft. from S. Line

850 Ft. from E. Line

_____ Ft. from W. Line

Cowley County

Location _____

Rig up _____

Drilling and Remarks:

Bar Y 3374
5" @ 3374
209 to 3381-91
Pump 50 P.F.
380 G

RECORD

Cased _____ in., _____ ft.

Sand _____

Gas _____

Oil _____

Total Depth 3378

PRODUCTION

1st 24 hrs. Nat. _____

1st 24 hrs. after shot _____

Gas _____ Cu. Ft.

Dry Hole _____

Abandoned _____

Date

MAY 24 1944

19

S. J. LEWIS

Scout