

KANSAS

Cowley

FORM 51 5M PETROL

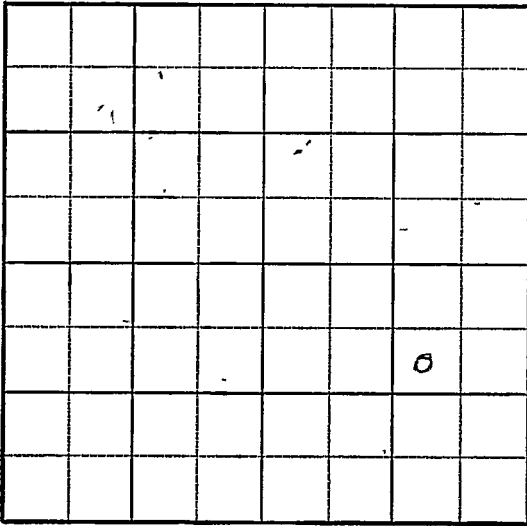
O. W. D. D.

Section 20 Township 34 Range 3EWell No. 1 TeasdaleCompany ~~Nelson Drig.~~ *Shagner*

NORTH

WEST

EAST



SOUTH

O. W. D. D.

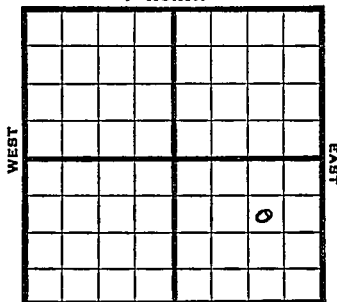
KANSAS

Cowley

Sec. 20 Twp. 34 R. 3-EWell No. #1 Teasdall Farm~~Nelson Drlg.~~

Company

NORTH

990 Ft. from N. Line

Ft. from S. Line

990 Ft. from E. Line

Ft. from W. Line

SW NE SE

SOUTH

1945 Elev. 1149 REPORT

9/19 Drlg. 150'

9/26 10" @ 112

Drlg. 2165

10/3 Stal. 2220

Lay. 2670

Chat. 2391

TD 3406'

ABANDONED

1956

O. W. D. D.

7-18 OTD 3408

CO DD 3435

D & A

Stal. 2220'; Lay. 2670'; M. 3391';

FIRST REPORT

ABANDONED

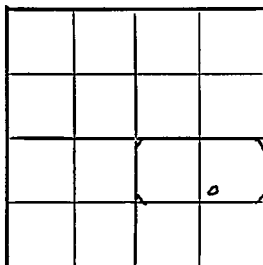
KANSASPool Name MiscellaneousMap No. 1 Sec. 20 Twp. 34 R. 3EWell No. 1 Teasdall

Nelson Drlg. _____ Company

FIRST REPORT

Contractor _____

SW NE SE

SECTION PLAT990 Ft. from N. Line

_____ Ft. from S. Line

990 Ft. from E. Line

_____ Ft. from W. Line

Cowley County

RECORD

Location _____

Rig up _____

Drilling and Remarks:

150'

Cased _____ in., _____ ft.

Sand _____

Gas _____

Oil _____

Total Depth _____

PRODUCTION

1st 24 hrs. Nat. _____

1st 24 hrs. after shot _____

Gas _____ Cu. Ft.

Dry Hole _____

Abandoned _____

Date

SEP 19 1945 19 S. J. LEWIS Scout

KANSAS Kansas Pool Name Miscellaneous
 Map No. 1 Sec. 20 Twp. 34 R. 3E
 Well No. 1 Teasdall

Nelson Drlg. _____ Company _____

ABANDONED

Contractor _____

SW NE SE

E1,1149
SECTION PLAT

990 Ft. from N. Line

_____ Ft. from S. Line

990 Ft. from E. Line

_____ Ft. from W. Line

			8

Cowley County

Location _____

Rig up _____

Drilling and Remarks:

Stab 2220
Log 2670
Chas 20391

RECORD

Cased _____ in., _____ ft.

Sand _____

Gas _____

Oil _____

Total Depth 3456

PRODUCTION

1st 24 hrs. Nat. _____

1st 24 hrs. after shot _____

Gas _____ Cu. Ft.

Dry Hole _____

Abandoned _____

Date

OCT 3 1945 19 S. J. LEWIS Scout

O. W. D. D.

County Cowley Elev. _____
 Sec. 20 Twp. 34 Rge. 3E
 Company Wagner (was Nelson)
 Farm Name Teasdall No. 1

TOPS	DEPTH	LOG	DATUM	Loc. in Sec.
Anh.				SW NE SE
Tr.				
H. <u>Stal.</u>	<u>2220</u>			
Tr.				
Dg. <u>Layton</u>	<u>2670</u>			OWD D.
BL.				
L.				Geol.
K.C.				Contr.
B.K.C.				Smitherman
Ce.				
C.				Pool
M.				Gibson
M.	<u>3391</u>			
K.				
Mz.				
Mo.				
V.				
S.				
S.				
A.				
R.				
Pe.				
G.				
T.D.				

FIRST REPORT
ABANDONED

Date Comm. JUL 18 '56

OTD 3408 CO DD 3435

D & A

SEE 8 BJA

29