


Section 21 Township 34 Range 3E

Well No. 3 Rouch

Company Crest Petr.

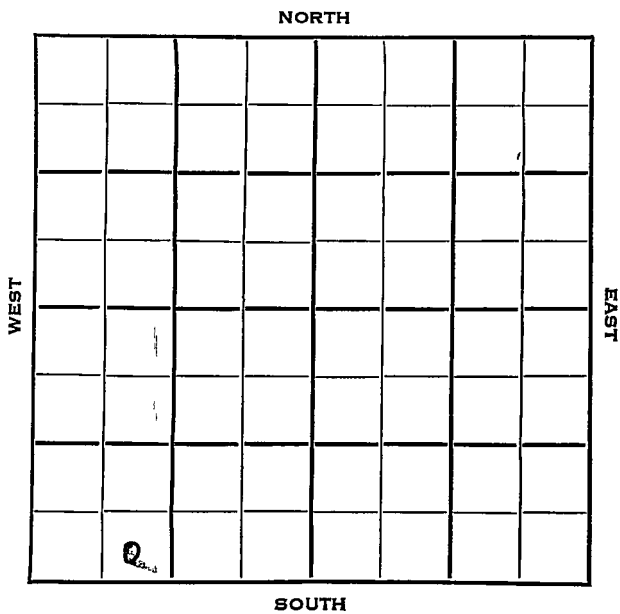

Cowley

KANSAS

SEC.	TWP.	R.
21	34	3E

WELL NO. #3 Rouch FARM

COMPANY Crest Petroleum

CONTRACTOR Crest Pet.


Gibson Pool

_____ Ft. from N. Line

330 _____ Ft. from S. Line

_____ Ft. from E. Line

990 _____ Ft. from W. Line

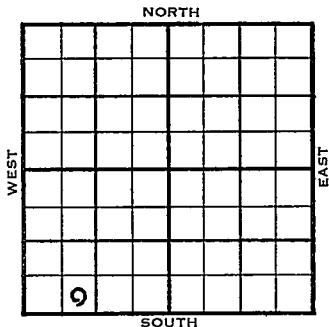

SE SW SW

	ELEVATION	REPORT
1954	1140'	
3/17	Spud 3-10-54 8" @ 95' Drlg 2460'	
5/5	Spud 3-10-54 Oil well TD 3416 8" @ 95' Layton 2658 Bart. 3360 Miss. 3400 TD 3415 5" @ 3401 DD 3416 PB 3393 9/3373-76 72/3380-92 sd-frac S/50 BO 20 BWPD Comp. 49 BOPD 59% wtr.	
	COMPLETED	

