


KANSAS

Cowley

Section 21 Township 34 Range 3E

Well No. #1 Bottom Rouch

Company ~~Texas~~ CREST PET

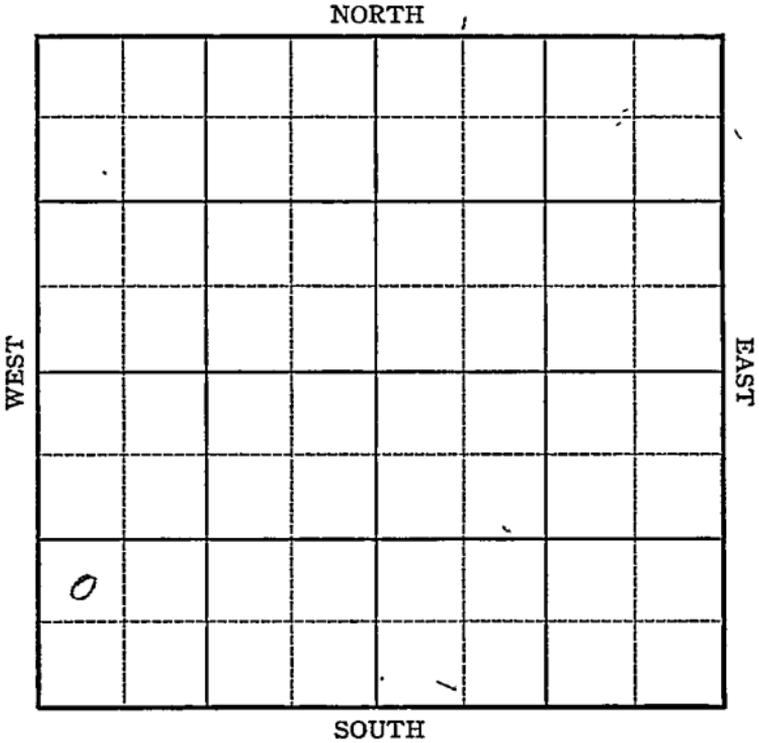

Sec. 21 Twp. 34 R. 3E

Well No. #1 Bottom Rock Farm

~~Texas~~ CREST PET. Company


Miscellaneous

\_\_\_\_\_ Ft. from N. Line

990 Ft. from S. Line

\_\_\_\_\_ Ft. from E. Line

330 Ft. from W. Line

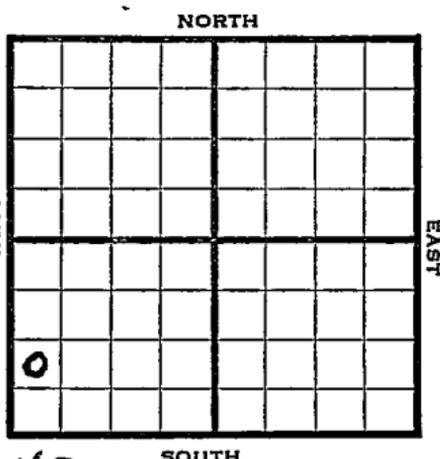

*Elev. DF 1143*

1944

Elev. 1143' REPORT

- 7/19 Loc.
- 7/26 "
- 8/2 Rot.
- 8/9 "
- 8/16 10" @ 205 Drlg. 1740
- 8/23 Drlg. 3210
- 8/30 Bart 3370  
Miss 3391 SO  
Drlg. 3434
- 9/8 Drlg. 3720'
- 9-13 Miss 3390  
Kind 3686  
Simp 3737,  
Arb 3802  
TD 3847

**ABANDONED**

O.W.W.O.

1952  
5/14

- Bart. 3370 Miss. 3391
- Kh. 3686 Chat 3710
- Simp. 3737 Arb. 3802
- OTD 3847' / MIR

- 8/13 D&A TD 3847 Bart 3370 Miss 3391
- Kh 3686 Chat 3710 Simp 3737
- Arb. 3802 OTD 3847 GO to 3500
- 5" @ 3438 31/3375-85 FU 900' wtr
- 250' oil overnite S/10 bopd 40 bw
- D&A

**ABANDONED**

KANSAS

Pool Name MiscellaneousMap No. 1 Sec. 21 Twp. 34 R. 3EWell No. 1 BootomTexas


Company \_\_\_\_\_

FIRST REPORT

Contractor \_\_\_\_\_

NW SW SW

## SECTION PLAT

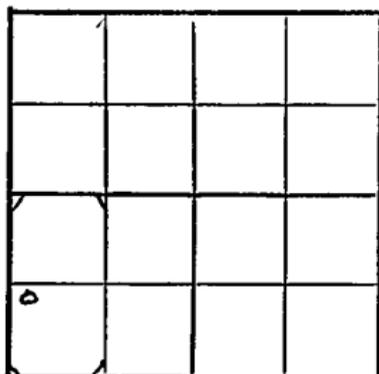

\_\_\_\_\_ Ft. from N. Line

990

\_\_\_\_\_ Ft. from S. Line

\_\_\_\_\_ Ft. from E. Line

330

\_\_\_\_\_ Ft. from W. Line

Cowley CountyLocation X

Rig up \_\_\_\_\_

Drilling and Remarks:

## RECORD

Cased \_\_\_\_\_ in., \_\_\_\_\_ ft.

Sand \_\_\_\_\_

Gas \_\_\_\_\_

Oil \_\_\_\_\_

Total Depth \_\_\_\_\_

## PRODUCTION

1st 24 hrs. Nat. \_\_\_\_\_

1st 24 hrs. after shot \_\_\_\_\_

Gas \_\_\_\_\_ Cu. Ft.

Dry Hole \_\_\_\_\_

Abandoned \_\_\_\_\_

Date

JUL 1 9 1944 19S. J. LEWIS Scout





