


Section 21 Township 34 Range 3 E

Well No. #2 Rouch

Company Crest Pet.

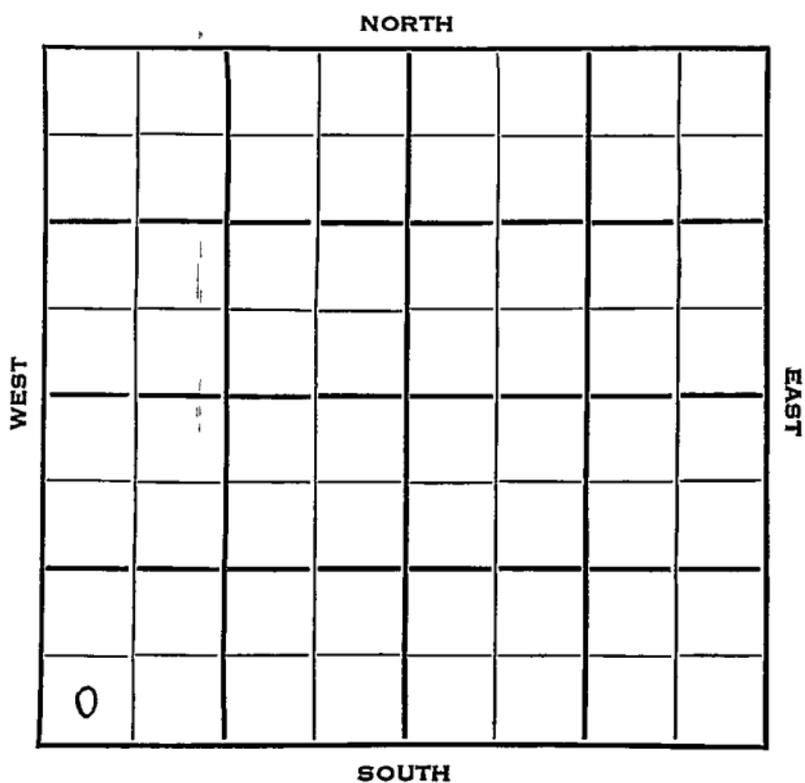

Cowley

KANSAS


SEC.	21	TWP.	34	R.	3E	✓
------	----	------	----	----	----	---

WELL NO #2 Rouch FARM

COMPANY Crest Pet.

CONTRACTOR Fortier & Wright
Gibson Pool

_____ Ft. from N. Line
330 _____ Ft. from S. Line
_____ Ft. from E. Line
330 _____ Ft. from W. Line
SW SW SW

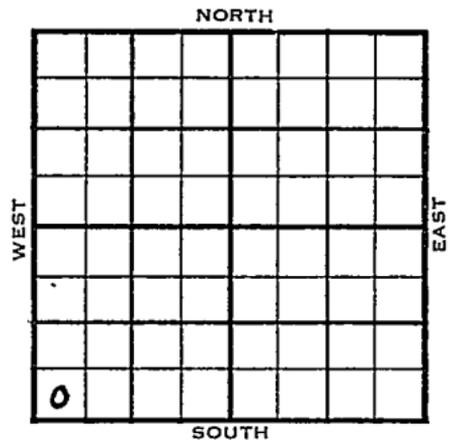

	ELEVATION	REPORT
1953	1139'	
12/30	M I R,	
1954		
3/17	Spud 12-30-53 Oil well TD 3420 8" @ 96 Bart 3369 Miss 3404 TD 3420 5" @ 3420 CO to 3410 8/3360-64 60/3374-87 S/6 BOPH 35 BW F/35 BOPH 6 hr. Comp. 65 BOPD	
	COMPLETED	

