

Rice

FORM 51


KANSAS

Section 3 Township 18 Range 8W

Well No. #7 Dubrinski

Company Raymond Oil

NORTH

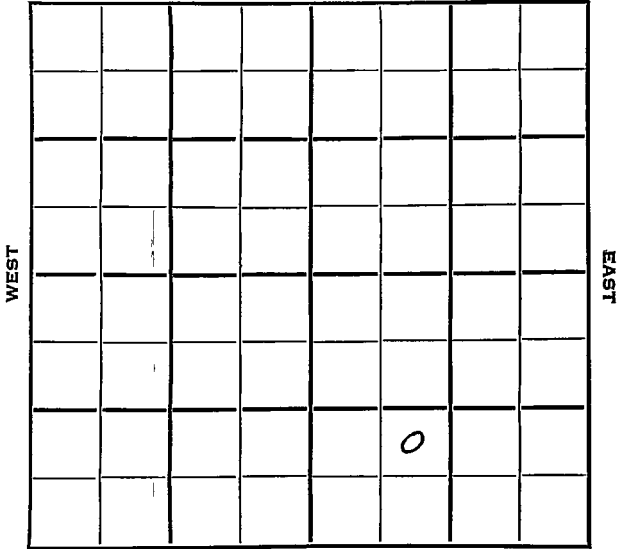

SOUTH

Rice KANSAS

SEC	TWP.	R.
3	18	8W


WELL NO. **7 Dubrinski** FARM

COMPANY **Raymond Oil**

CONTRACTOR **Murfin Drlg.**

**Geneseo Pool**

\_\_\_\_\_ Ft. from N. Line  
**990** \_\_\_\_\_ Ft. from S. Line  
 \_\_\_\_\_ Ft. from E. Line  
**990** \_\_\_\_\_ Ft. from W. Line

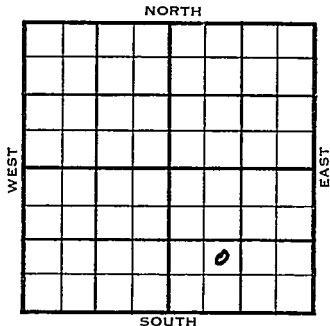

NE SW SE

1954	ELEVATION	REPORT
	1786'	

1/6 Spud 1-1-54  
 8" @ 235'  
 Drlg. 1550'

1/13 Heeb 2715', Br 14 2839', Lans 2865',  
 B KC 3174', Cong 3211',  
 DST 3228-42', 1 hr., 5' M  
 Simp 3246', Arb. 3264'  
 RTD 3270'  
 5" @ 3265'

1/20 NR

1/27 CO 3270, FU 2900' oil

2/3 50 M-A

2/10 Spud 1-1-54 Oil well TD 3270  
 8" @ 235' Heeb 2715' Br. lime 2839  
 Lans. 2865 B KC 3174 Cong. 3211  
 DST 3228-42 open 1 hr rec 5' mud 0#  
 Simp. 3246 Arb. 3264 TD 3270  
 5" @ 3265 CO to 3270 FU 2900' oil  
 50 mud-acid. FU 2900' oil.  
 Comp. 431 BOPD

**COMPLETED**



