


Section 3 Township 18 Range 8-W

Well Number #3 Edwards

Company Skiles et al

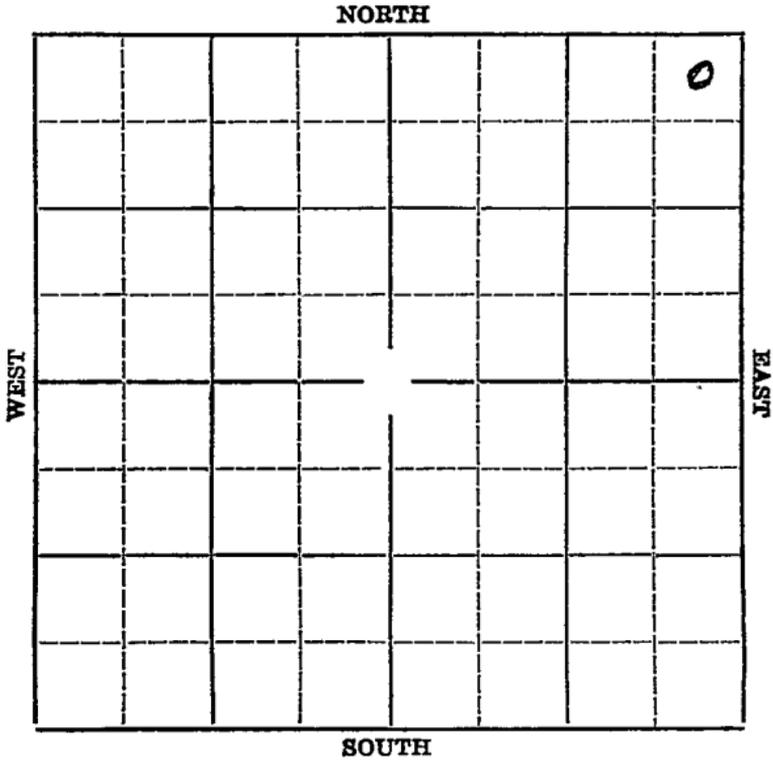

Map No. KANSAS Sec. 3 Twp. 18 R. 8W

Well No. #3 Edwards Farm

Skiles et al Company


330' Ft. from N. Line

_____ Ft. from S. Line

330' Ft. from E. Line

_____ Ft. from W. Line

Elev. 1785

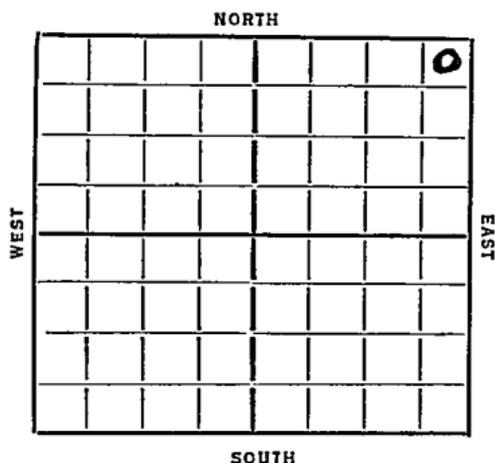

~~1936~~

REPORT

7/8 Cellar

7/16 Rig.

7/23 Rigging up.

7/30 232' - 12 1/2". Drlg. 394'.

8/6 Drlg. 1255'.

8/13 8" @ 2189'. Drlg. 2205'.

8/20 Drlg. 2486'.

8/27 8" @ 2486'. Drlg. 2645'.

9/3 Drlg. 2930'.

9/30/36 - Conglomerate 3240'.

T.D. 3422'.

Siliceous 3422 CORRECTED.

Hole full of water.

Dry and abandoned.

ABANDONED

Form 26-1M-Bl-2-29 Rice

KANSAS

Map No. 45 Sec. 3 Twp. 18 R. 8W

Well No. 3 Edwards

Shiles & Co Company

Contractor

SECTION PLAT

230 Ft. from N. Line

Ft. from S. Line

230 Ft. from E. Line

Ft. from W. Line

| | | | |
|--|--|--|---|
| | | | 0 |
| | | | |
| | | | |
| | | | |

FIRST REPORT

Location

Rig up

Drilling and Remarks:

Ce Har

RECORD

Cased in., ft.

Sand

Gas

Oil

Total Depth

PRODUCTION

1st 24 hrs. Nat.

1st 24 hrs. after shot

Gas Cu. Ft.

Dry Hole

Abandoned

Date

JUL 8 1936 19

S. J. LEWIS Scout

KANSAS

Form 26-1M Bks.-2-29

Map No. 45 Sec. 3 Twp. 15 R. 8W

Well No. 3 Edwards

Spiles & Dal Company

Contractor

SECTION PLAT

| | | | |
|--|--|--|---|
| | | | o |
| | | | |
| | | | |
| | | | |
| | | | |

330 Ft. from N. Line

_____ Ft. from S. Line

330 Ft. from E. Line

_____ Ft. from W. Line

ABANDONED

Location _____

Rig up _____

Drilling and Remarks:

Conglomerate
3240
Siliceous
3422 corrected
X FW
DXH

RECORD

Cased _____ in., _____ ft.

Sand _____

Gas _____

Oil _____

Total Depth 3422

PRODUCTION

1st 24 hrs. Nat. _____

1st 24-hrs. after shot _____

Gas _____ Cu. Ft.

Dry Hole _____

Abandoned _____

Date

SEP 30 1936 19

S. J. LEWIS

Scout