
Form 51—5M—3-35—Mid-West

Rice

Map No. [illegible] Sec. 3 Twp. 18 R. 8W

Well No. #3-Jansen Farm

Empire Oil Company

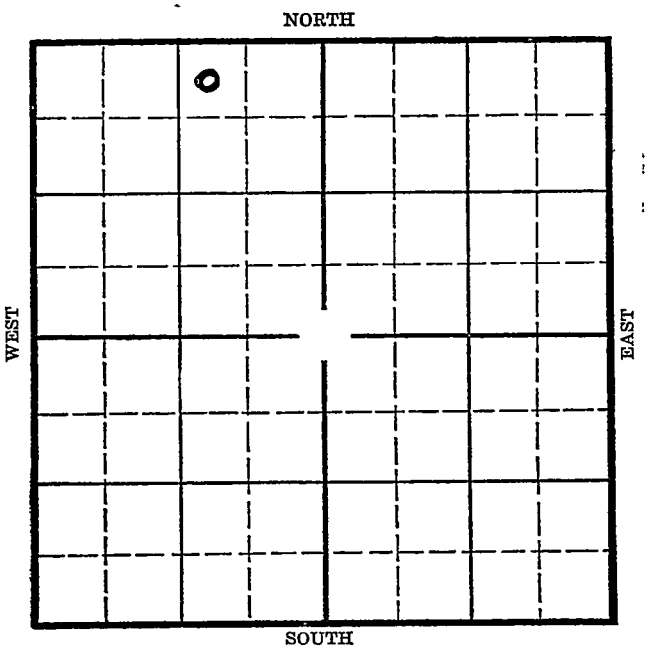

Location

Drilling Remarks

Rig Up

Drilling Remarks

RECORD

Cased ____ in. ____ ft.

Sand

Gas

Oil

Total Depth

PRODUCTION

1st 24 hrs. Nat.

1st 24 hrs. after shot

Gas ____ cu. ft.

Dry Hole

Abandoned

RICE

Form 252-A
5M 7-35 MPC

Map No. KANSAS Sec. 3 Twp. 18 R. 8-W

Well No. 3-Jansen Farm


Empire Oil Company

330 Ft. from N. Line

Ft. from S. Line

990 Ft. from E. Line

Ft. from W. Line

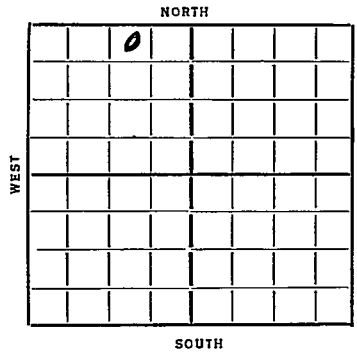

Elev. 1779

Date 1936	REPORT
4/1	Location
4/10	--
4/16	--4/23--
4/30	Cellar & S.D.
5/7	R.O.G.
5/14	Rig.
5/21	Drlg. 290'.
5/28	Drlg. 2225'.
6/4	Drlg. 3200'.
6/11	Rigging up standard tools.
6/18	Sil. 3234'. T.D. 3265'. 1370' oil in 27 hours.
6/25	Shut down.
7/2	3000 gallons of acid. 435 bbls of oil in 24 hours.
7/9	Testing.
7/15	/36-Sil. 3234'. T.D. 3260'. COMPLETED 3000 gallons of acid. 435 bbls of oil potential.

COMPLETED

Form 26—1M Blk.—9-28

KANSAS

Map No. 45 Sec. 3 Twp. 18 R. 8W

Well No. 3- Jansen

Empire Oil Company

Contractor

FIRST REPORTS


330 Ft. from N. Line

Ft. from S. Line

990 Ft. from E. Line

Ft. from W. Line

SECTION PLAT

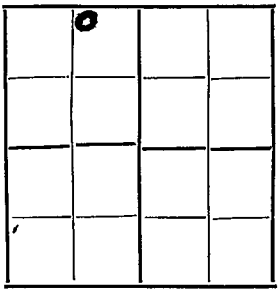

Location ✓

Rig up

Drilling and Remarks:

RECORD

Cased in., ft.

Sand

Gas

Oil

Total Depth

PRODUCTION

1st 24 hrs. Nat.

1st 24 hrs. after shot

Gas Cu. Ft.

Dry Hole

Abandoned

Date

4-1-36 192

ORVAL MANNSCHRECK Scout

Form 26—1M Bks.—2-29

KANSAS

Rice


Map No. 43 Sec. 3 Twp. 18 R. 9W

Well No. 3 Jansen

Eaton Fisher Company

Contractor

SECTION PLAT

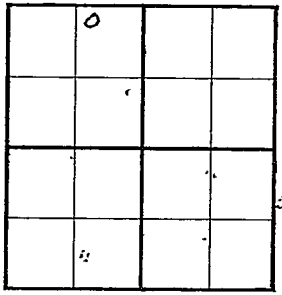

330 Ft. from N. Line

Ft. from S. Line

990 Ft. from E. Line

Ft. from W. Line

COMPLETED

Location

Rig up

Drilling and Remarks:

S. C 3234

3000 acid

435 B.O.P.

RECORD

Cased in., ft.

Sand

Gas

Oil

Total Depth 3260

PRODUCTION

1st 24 hrs. Nat.

1st 24 hrs. after shot

Gas Cu. Ft.

Dry Hole

Abandoned

Date

JUL 15 1936 19

S. J. LEWIS Scout