


Rice

KANSAS

Section 3 Township 18 Range 8W

Well No. #8 Dobrinski

Company Francis Raymond

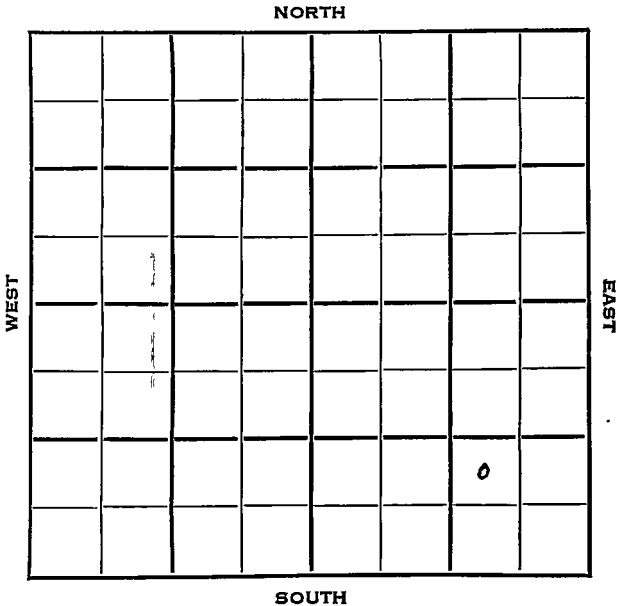

Rice KANSAS

SEC.	TWP.	R.
3	18	8W ✓

WELL NO.

8 Dobrinski

FARM

COMPANY

Francis Raymond

CONTRACTOR

Murfin Drlg.

Geneseo-Edwards Pool

Ft. from N. Line

990


Ft. from S. Line

990

Ft. from E. Line

Ft. from W. Line

NW SE SE

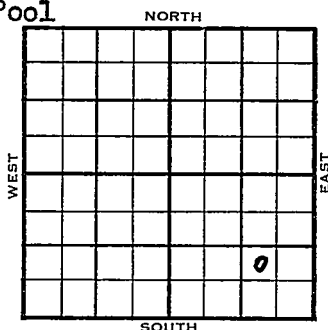

	ELEVATION	REPORT
1954	1783'	

3/17	Location
3/24	8" @ 238' w/125 sks Drlg. 2610'
3/31	Heeb 2713 Br. li 2835' Lans 2862 B KC 3174 Cong. 3229' Simp 3262 Arb. 3282 RTD 3285 5" @ 3283
4/7	WOCT
5/19	Spud 3-17-54 Oil well TD 3319 8" @ 238 Heeb 2713 Br lime 2835 Lans. 2862 B KC 3174 Cong. 3229 Simp. 3262 Arb. 3282 TD 3285 5" @ 3283 DD 3304 6½ BFPH DD3310 DD 3319 PB 3306 300 A S/5 BFPH 50% wtr. Comp. 81 BOPD 57% wtr.

COMPLETED

County Rice State Kansas
 Sec. 3 (Blk.) 18 (Sur.) SW Map No.
 Operator Francis Raymond
 Well No. 8 Farm Dobrinski
 Elev. _____ Location NW SE SE

FIRST REPORT


990 Ft. From S Line SE
 990 Ft. From E Line Quarter
 1st. Report MAR 17 1954
 Completion _____
 Remarks Murfin Drlg. - Contr.
 Spudding Date _____

Drlg. Data

Geneseo-Edwards PoolLocation

J. G. McGEHEE

County Rice State Kansas
 Sec. 3 (Blk.) 18 (Sur.) 8W Map No.
 Operator Francis Raymond
 Well No. 8 Farm Dobrinski
 Elev. 1783 Location NW SE SE

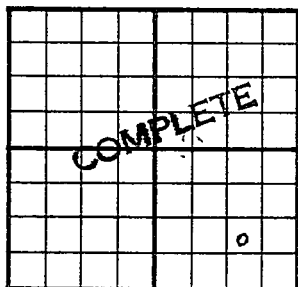

990 Ft. From S Line SE
990 Ft. From E Line Quarter

1st. Report

Completion MAY 1 9 1954

Remarks Geneseo-Edwards Pool
Murfin Drlg. - Contr.

Spudding Date 3-17-54

Drlg. Data Oil well TD 3319

8" @ 238 Heeb. 2713 Br. lime 2835

Lans. 2862 B KC 3174 Cong. 3229

Simp. 3262 Arb. 3282 TD 3285

5" @ 3283 DD 3304 6 $\frac{1}{2}$ bfph DD 3310

DD 3319 PB 3306 300 A S/ 5 bfph

50% wtr. Comp. 81 bopd 57% wtr.

J. G. McGEHEE