


Map No. _____ Sec. 16 Twp. 28 R. 4
 Well No. 3 L C Curry Farm _____
Empire Company _____

NORTH

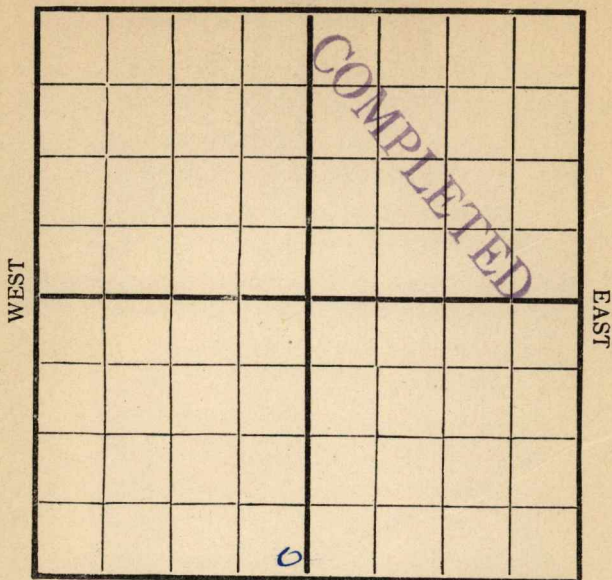

SOUTH

Location _____

Drilling Remarks:

620 - 1200 ft.

Rig Up _____

Drilling Remarks:

RECORD

Cased _____ in _____ Ft.
 Sand _____
 Gas _____
 Oil _____
 Total Depth _____


PRODUCTION

1st 24 hrs. Nat. _____
 1st 24 hrs. after shot _____
 Gas _____ Cu. Ft.
 Dry Hole _____
 Abandoned _____

Map No. _____ Sec. 16 Twp. 28 R. 4
 Well No. 3 L.C. Perry Farm _____
Coat Oct 1 Company _____

NORTH

WEST

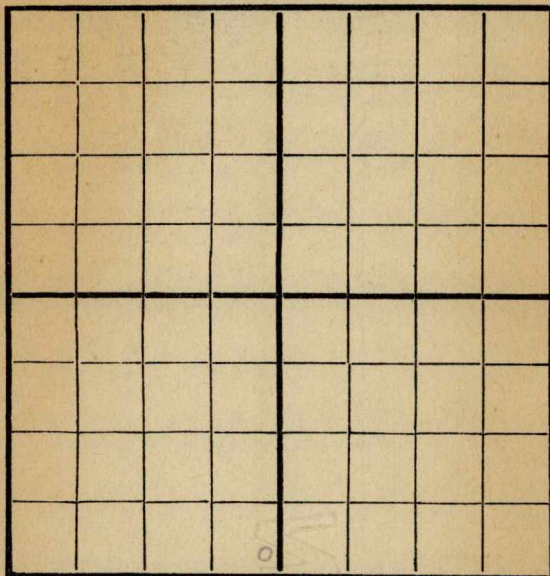

EAST

SOUTH

Location _____
 Rig Up _____
 Drilling and remarks _____

425'

RECORD

Cased _____ in. _____ Ft.
 Sand _____
 Gas _____
 Oil _____
 Total Depth _____

PRODUCTION

1st 24 hrs. Nat. _____
 1st 24 hrs. after shot _____
 Gas _____ Cu. Ft.
 Dry Hole _____
 Abandoned _____

Date

6/7

191

6


L.C. Perry

Scout

Map No. _____ Sec. 16 Twp. 28 R. 4
 Well No. 3 P. P. Curry Farm _____
Co. Company _____

NORTH

WEST

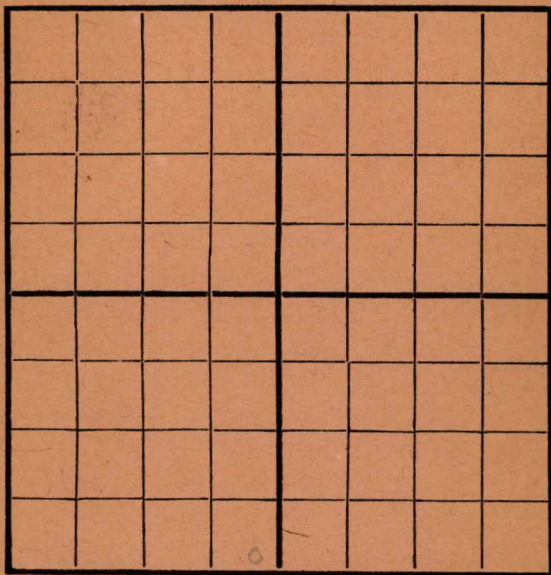

EAST

SOUTH

Location _____

Rig Up _____

Drilling and remarks

1200' Shut
Down

RECORD

Cased _____ in. _____ Ft

Sand _____

Gas _____

Oil _____

Total Depth _____

PRODUCTION

1st 24 hrs. Nat. _____

1st 24 hrs. after shot _____

Gas _____ Cu. Ft

Dry Hole _____

Abandoned _____

Date

6/30 1916 P. P. Curry Scout

Map No. _____ Sec. 16 Twp. 28 R. 4

Well No. 3 L.C. Curry Farm

_____ **Company**

NORTH

WEST

EAST

SOUTH

Location _____

Rig Up

Drilling and remarks

RECORD

Cased _____ in. _____ Ft.

Sand _____

Gas _____

Oil _____

Total Depth _____






PRODUCTION

1st 24 hrs. Nat. _____

1st 24 hrs. after shot_____

Gas _____ Cu. Ft.

Dry Hole


Abandoned _____

Date _____

6/30, 1916. *P. C. Condit* Scout

Map No. _____ Sec. 16 Twp. 28 R. 4
 Well No. 3 Cherry Farm _____
Count Company _____

NORTH

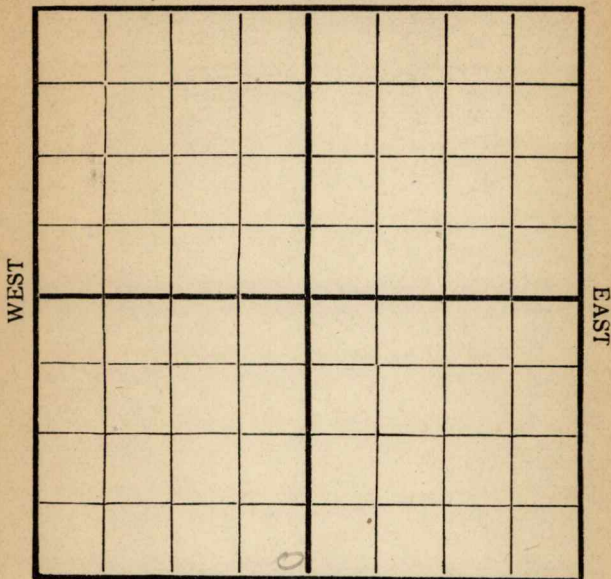

SOUTH

Location _____
 Rig Up _____
 Drilling and remarks _____

1850

RECORD

Cased _____ in. _____ Ft.
 Sand _____
 Gas _____
 Oil _____
 Total Depth _____

PRODUCTION

1st 24 hrs. Nat. _____
 1st 24 hrs. after shot _____
 Gas _____ Cu. Ft.
 Dry Hole _____
 Abandoned _____

Date

7/8, 191 6 H. Carle Scout

Map No. _____ Sec. 16 Twp. 28 R. 4Well No. 3 Curry Farm _____

Company _____

NORTH

WEST

EAST

SOUTH

Location _____

Rig Up _____

Drilling and remarks _____

RECORD

Cased _____ in. _____ Ft.

Sand _____

Gas _____

Oil _____

Total Depth _____

PRODUCTION

1st 24 hrs. Nat. _____

1st 24 hrs. after shot _____

Gas _____ Cu. Ft.

Dry Hole _____

Abandoned _____

Date


7/21, 1916 B. C. Condry Scout

Map No. _____ Sec. 16 Twp. 28 R. 4
 Well No. 3 Curry Farm _____
Curry Company _____

NORTH

WEST

EAST

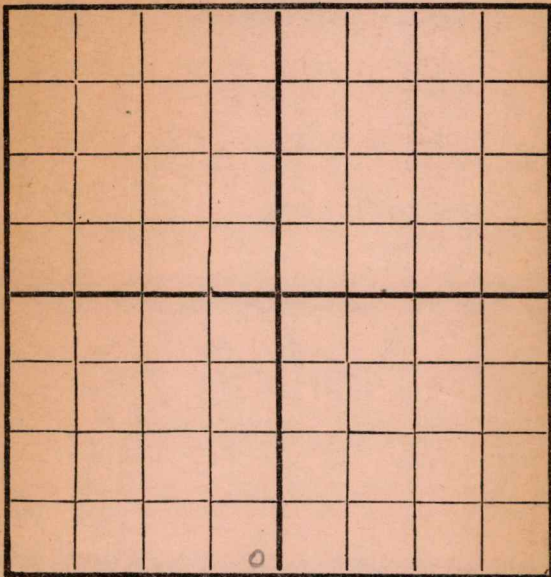

SOUTH

Location _____
 Rig Up _____
 Drilling and remarks _____

2060

RECORD

Cased _____ in. _____ Ft.
 Sand _____
 Gas _____
 Oil _____
 Total Depth _____

PRODUCTION


1st 24 hrs. Nat. _____
 1st 24 hrs. after shot _____
 Gas _____ Cu. Ft.
 Dry Hole _____
 Abandoned _____

Date 8/8, 191 6 Scout

Map No. _____ Sec. 16 Twp. 38 R. 4Well No. 3 Curry Farm _____
Enterprise Company _____

NORTH

WEST

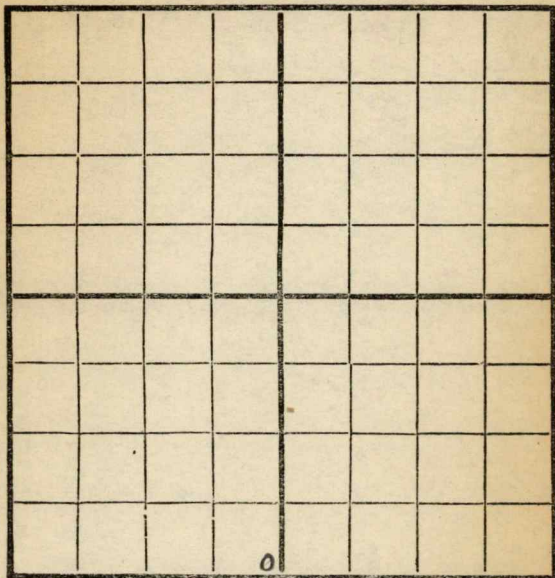

EAST

SOUTH

Location _____

Rig Up _____

Drilling and remarks

2185Shut Down

RECORD

Cased _____ in. _____ Ft.

Sand _____

Gas _____

Oil _____

Total Depth _____

PRODUCTION

1st 24 hrs. Nat. _____

First 24 hrs. after shot _____

Gas _____ Cu. Ft.

Dry Hole _____

Abandoned _____

Date

8/141916Wendell

Scout

Map No. _____ Sec. 16 Twp. 28 R. 4Well No. 3 Coe Farm _____

_____ Company _____

NORTH

WEST

EAST

SOUTH

Location _____

Rig Up _____

Drilling and remarks

2500-
 On top sand
 casing 5 3/16

RECORD

Cased _____ in. _____ Ft.

Sand _____

Gas _____

Oil _____

Total Depth _____

PRODUCTION

1st 24 hrs. Nat. _____

First 24 h.s. after shot _____

Gas _____ Cu. Ft.

Dry Hole _____

Abandoned _____

Date


8/21, 1916 Wendy Sc _____

Map No. _____ Sec. 16 Twp. 28

Well No. 3 Cherry
Empire

NORTH

WEST

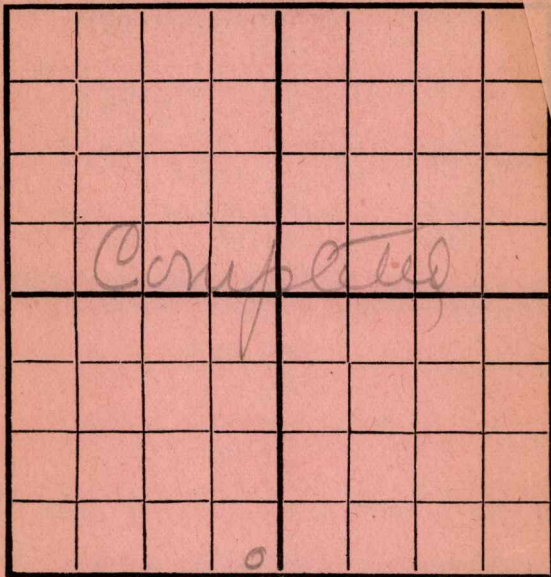

EAST

SOUTH

Location _____

Rig Up _____

Drilling and remarks

*got 2 yd
about
175 lbs*

RECORD

Cased _____ in. _____ Ft.

Sand 2500-2516

Gas _____

Oil _____

Total Depth _____

PRODUCTION

1st 24 hrs. Nat. _____

1st 24 hrs. after shot _____

Gas _____ Cu. Ft.

Dry Hole _____

Abandoned _____

Date

30 1916

191

L. Condyff

Scout