

Section 3 Township 18 Range 8W

Well No. 3 Jansen

Company R.I. Williams

Jansen Pool

NORTH

0							

WEST

EAST

SOUTH



Sec. 3 **KANSAS** Twp. 18 R. 8W

Well No. #3 Jansen Farm  
R. L. Williams Company  
**Jansen Pool**


\_\_\_\_\_ Ft. from N. Line

990' Ft. from S. Line

\_\_\_\_\_ Ft. from E. Line

330' Ft. from W. Line

NW SW NW

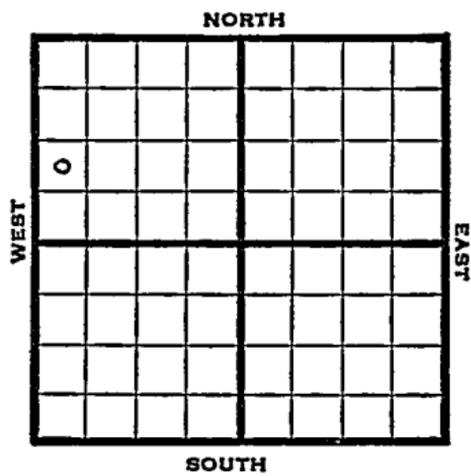

1948 Elev. 1773' REPORT

9/8 Surface Hole  
 9/14 8" @ 197'  
 Lansing 2939'  
 Arb. 3260  
 5" @ 3260  
 TD 3263' 500 acid  
 Swb 13 bbls oil PH

9/21 "  
 9/29 Arbuckle 3260'  
 5" @ 3260'  
 500 acid  
 Pump 75 oil & 30% W Pot.  
 Gr. 43°  
 TD 3263'

**COMPLETED**

Rice County Kansas State

Map No. Sec. 3 Twp. 18 R. 8W

Well No. 3 Jansen

R. L. Williams Company

FIRST REPORT Contractor

NW SW NW

SECTION PLAT


Ft. from N. Line

990 Ft. from S. Line

Ft. from E. Line

330 Ft. from W. Line

Jansen Pool

Remarks:

surface hole

Date SEP 8 1948

Scout S. J. LEWIS

Map No. 45 Sec. 3 Twp. 18 R. 8W

Well No. 3 Janssen

R. L. Williams Company

**COMPLETE**

Contractor

NW SW NW

E 1773  
SECTION PLAT

△			

\_\_\_\_\_ Ft. from N. Line

990 Ft. from S. Line

\_\_\_\_\_ Ft. from E. Line

330 Ft. from W. Line

Rice County

Location \_\_\_\_\_

Rig up \_\_\_\_\_

Drilling and Remarks:

*Per 43260*  
*5' @ 3260*  
*5-000 acid*  
*Pump 75 oil + 30%*  
*W.P.Y.*  
*43 2/3*

RECORD

Cased \_\_\_\_\_ in., \_\_\_\_\_ ft.

Sand \_\_\_\_\_

Gas \_\_\_\_\_

Oil  \_\_\_\_\_

Total Depth 826.9

PRODUCTION

1st 24 hrs. Nat. \_\_\_\_\_

1st 24 hrs. after shot \_\_\_\_\_

Gas \_\_\_\_\_ Cu. Ft.

Dry Hole \_\_\_\_\_

Abandoned \_\_\_\_\_

Date

SEP 29 1948

19

S. J. LEWIS

Scout