


Section 3 Township 18 Range 8-W

Well Number #4-Jansen

Company Empire

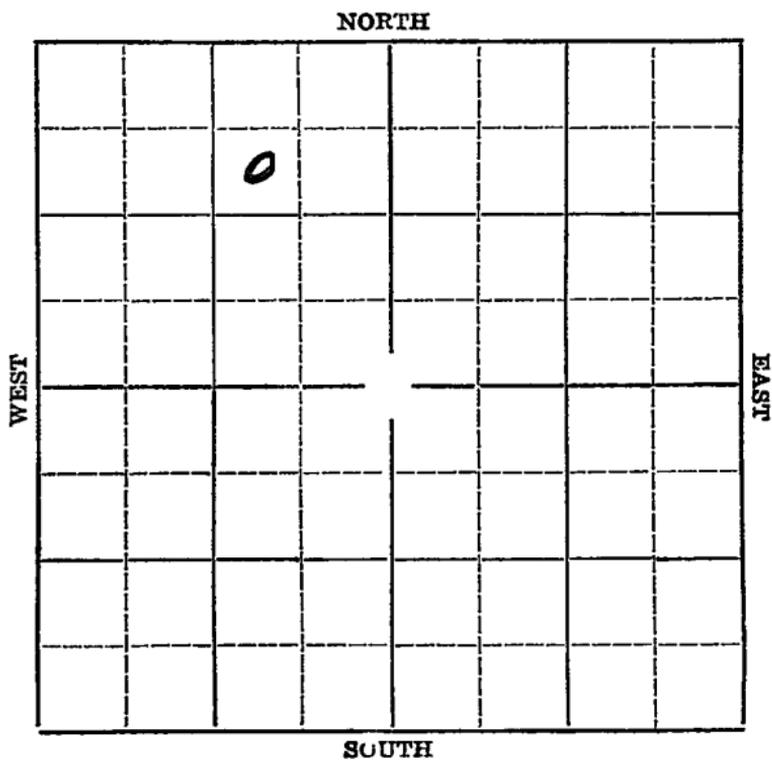

Map No. KANSAS Sec. 3 Twp. 18 R. 8W

Well No. #4 Jansen Farm _____
Empire Company _____


990' Ft. from N. Line

_____ Ft. from S. Line

990' Ft. from E. Line

_____ Ft. from W. Line

Elev. 1778

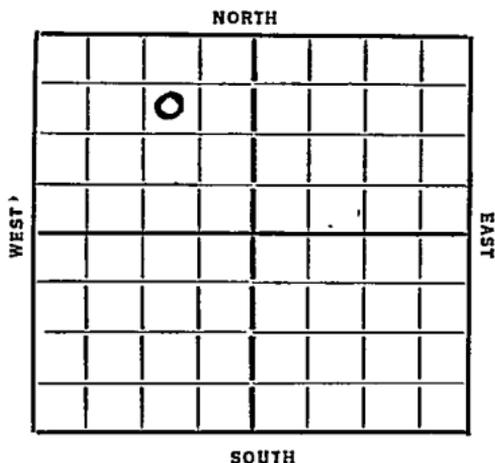

1936

REPORT

7/1 Location.

7/9 --

7/16 12" @ 201'. Waiting on cement.

7/23 Drlg. 2450'.

7/30 Drlg. 3177'.

8/6 Set 7" @ 3226'.

8/13 Siliceous 3243'. TD 3267'. 800' oil
3000 gallons of acid. No test.

8/20 15" @ 216' drlg.

8/27 10" @ 220'. Drlg. 2175'.

9/2/36-Sil. 3243'.

T.D. 3267'.

Shot 5 & 10 qts.

4000 gallons acid.

Potential 260 bbls of oil and

30 bbls of water.

COMPLETED

Rice

Map No. 45 Sec. 3 Twp. 18 R. 8W

Well No. H Jansen

Engle Company

Contractor

SECTION PLAT

	0		

990 Ft. from N. Line

_____ Ft. from S. Line

990 Ft. from E. Line

_____ Ft. from W. Line

FIRST REPORT

Location ✓

Rig up _____

Drilling and Remarks: _____

RECORD

Cased _____ in., _____ ft.

Sand _____

Gas _____

Oil _____

Total Depth _____

PRODUCTION

1st 24 hrs. Nat. _____

1st 24 hrs. after shot _____

Gas _____ Cu. Ft.

Dry Hole _____

Abandoned _____

Date

1911

970

19

S. J.

Scout

KANSAS

Map No. 45 Sec. 3 Twp. 18 R. 8W

Well No. 4 Johnson

Enterprise Company

Contractor

SECTION PLAT

	0		

990 Ft. from N. Line

_____ Ft. from S. Line

990 Ft. from E. Line

_____ Ft. from W. Line

COMPLETED

Location _____

Rig up _____

Drilling and Remarks:

Sil 3243
Shot 5x1095
4000 acid
Prod 260 oil
30 water.

RECORD

Cased _____ in., _____ ft.

Sand _____

Gas _____

Oil _____

Total Depth 3267

PRODUCTION

1st 24 hrs. Nat. _____

1st 24 hrs. after shot _____

Gas _____ Cu. Ft.

Dry Hole _____

Abandoned _____

Date

SEP 2 1936 19

S. J. LEWIS Scout