


Section 16 Township 28 Range 1E

Well No. #5 Varner

Company Franco - Central

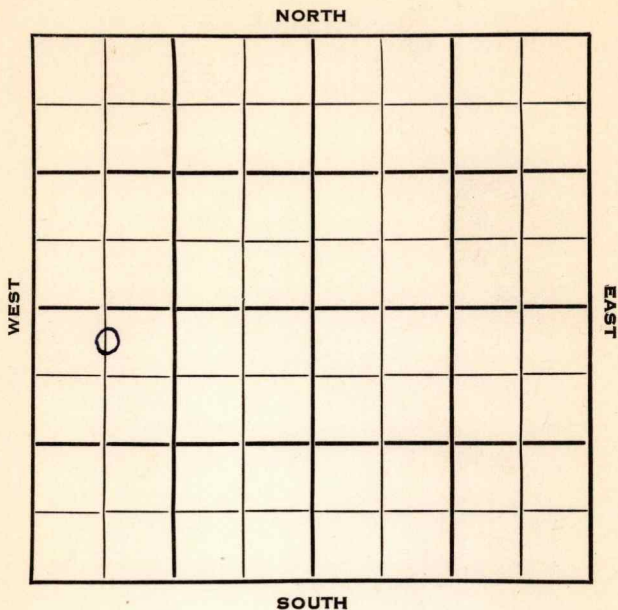

Sec. 16 Twp. 28 R. 4E

Well No. 5 Varner Farm

Franco-Central Company

Contractor


330 Ft. from N. Line

_____ Ft. from S. Line

_____ Ft. from E. Line

660 Ft. from W. Line

C N L NW SW

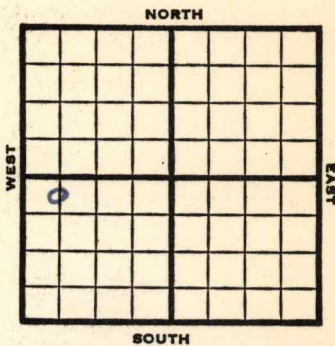

1953

Elev. 1206' REPORT

8/19 Cellar & pits

9/2 Spud 8-17-53

Oil Well

TD 2451'

8" @ 80'

Simp 2442, Arb 2447,

TD 2450'

5" @ 2448'

CO to 2450

DD 2451 FU 100' oil 1 hr. 500' oil 3 hr.

Comp. 25 bopd.

COMPLETED

County **Butler** State **Kansas**

Sec. **16** (Blk. (Twp.)) **28** (Sur. (Rge.)) **4E** Map No.

Operator **Franco - Central**

Well No. **5** Farm **Varner**

Elev. Location **C N L NW SW**

330 Ft. From **N** Line **SW**

660 Ft. From **W** Line **Quarter**

1st. Report **AUG 19 1953**

Completion

Remarks

Spudding Date

FIRST REPORT

Drig. Data

Cellar & pits

J. G. McGEHEE

