


Section 22 Township 34 Range 3E

Well No. 2 Berens

Company J. P. Booth

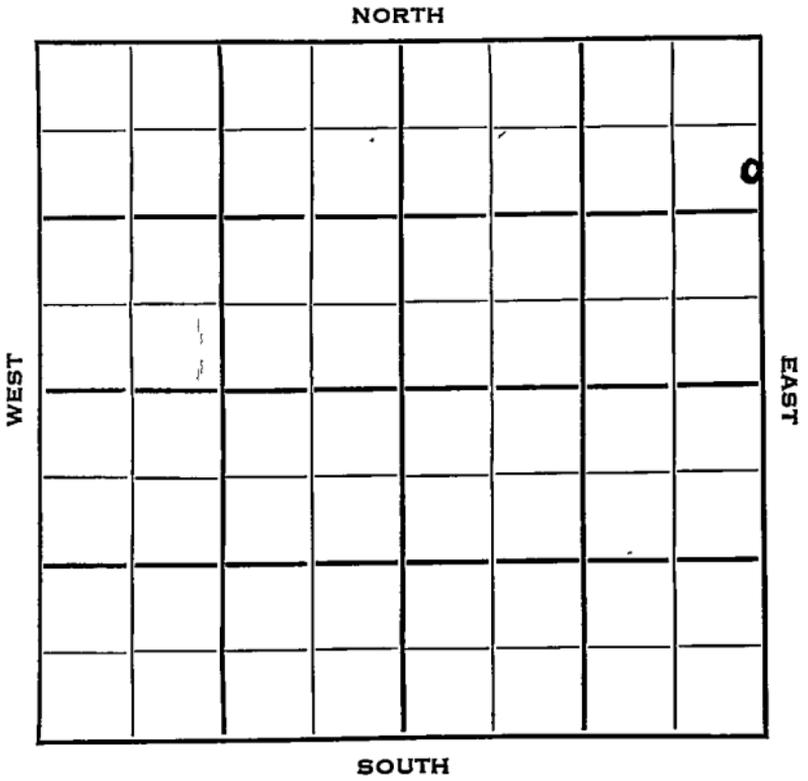

Cowley

KANSAS

SEC.	TWP.	R.
22	34	3E

WELL NO.

2 Berens

FARM

COMPANY

J. P. Booth

CONTRACTOR


Springer & Harper

1000 Ft. from N. Line

Ft. from S. Line

100 Ft. from E. Line

Ft. from W. Line

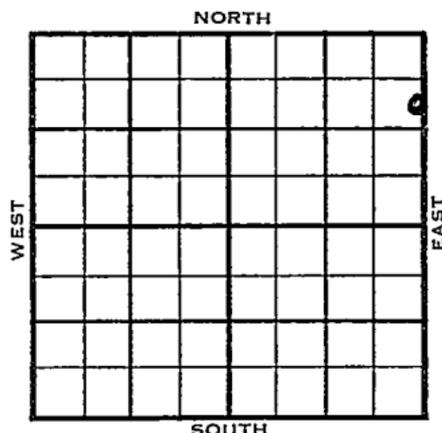

SE NE NE

1953

ELEVATION

1076'

REPORT

11/11

Spud 11-8-53
8" @ 81'
Drilg. 100'

12/30

Spud 11-8-53
Oil Well
TD 3260'
8" @ 81'
Stal. 2120', $\frac{1}{4}$ Layton 2620'
KC 2745'
TD 3260'
5 $\frac{1}{2}$ " @ 3260'
Bart 3233'
Sd 3248
CO to 3260
Sd-frac
F/15 boph
Comp. 215 bopd

COMPLETED

