

Map No. _____ Sec. 16 Twp. 28 R. 4Well No. 16 Varner Farm __________ Empire Company _____

NORTH



SOUTH

Location _____

Rig Up _____

Drilling Remarks:

Drilling Remarks:

RECORD

PRODUCTION

Cased _____ in _____ Ft.

1st 24 hrs. Nat. _____

Sand _____

1st 24 hrs. after shot _____

Gas _____

Gas _____ Cu. Ft.


Oil _____

Dry Hole _____

Total Depth _____

Abandoned _____

Map No. _____ Sec. 16 Twp. 28 R. 4
Well No. 16 Varner Farm _____
Campine Company _____
NORTH

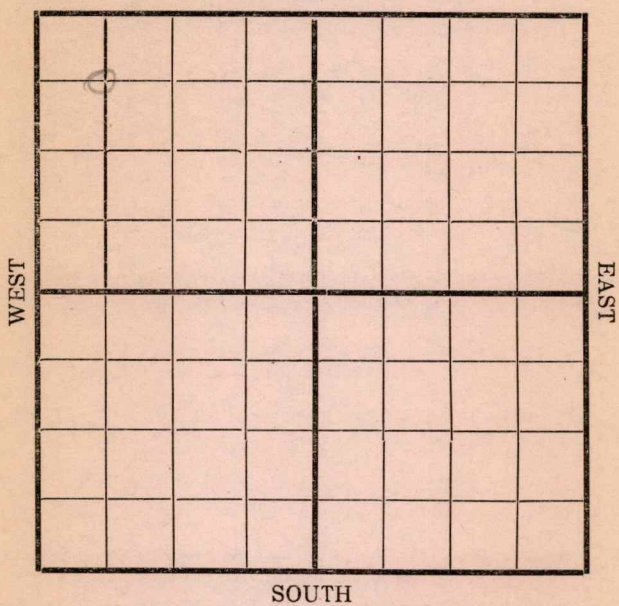

Location _____ Rig Up ☒ Drilling and remarks _____ FIRST REPORT	RECORD
	Cased _____ in. _____ Ft.
	Sand _____
	Gas _____
	Oil _____
	Total Depth _____
	PRODUCTION
	1st 24 hrs. Nat. _____
	1st 24 hrs. after shot _____
	Gas _____ Cu. Ft.
	Dry Hole _____
	Abandoned _____

Date 2/12, 1917 Cordell Scout

Map No. _____ Sec. 16 Twp. 28 R. 4Well No. 16 Harmer FarmEmpire Company

NORTH

WEST

EAST

SOUTH

Location _____

Rig Up _____

Drilling and remarks _____

RECORD

Cased _____ in. _____ Ft.

Sand _____

Gas _____

Oil _____

Total Depth _____

PRODUCTION

1st 24 hrs. Nat. _____

1st 24 hrs. after shot _____

Gas _____ Cu. Ft.

Dry Hole _____


Abandoned _____

Date

2/19, 1917 Candiff Scout

Map No. _____ Sec. 16 Twp. 28 R. 4
 Well No. 16 Harner Farm
Empire Company

NORTH

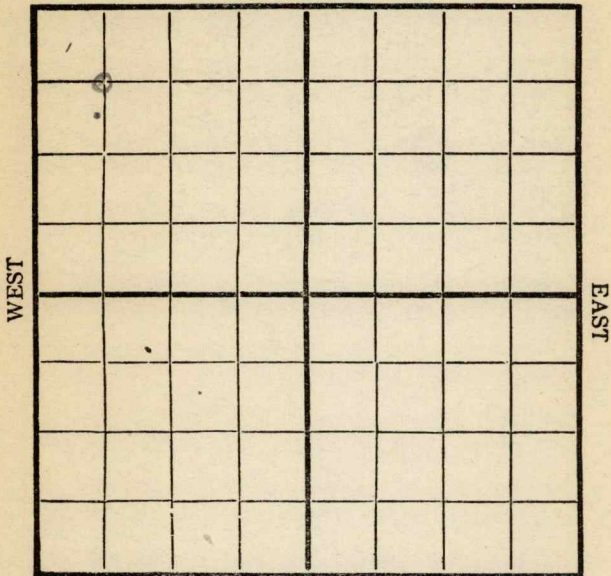

SOUTH

Location _____
 Rig Up _____
 Drilling and remarks _____

Spudding

RECORD

Cased _____ in. _____ Ft.
 Sand _____
 Gas _____
 Oil _____
 Total Depth _____

PRODUCTION

1st 24 hrs. Nat. _____
 First 24 hrs. after shot _____
 Gas _____ Cu. Ft.
 Dry Hole _____
 Abandoned _____

Date

Feb 7 1917 _____ Scout

Map No. _____ Sec. 16 Twp. 28 R. 4Well No. 16 Varner Farm
Empire Company

NORTH

WEST

EAST

SOUTH

REMARKS:

720

Date

3/5/20, 1912 Carroll Scout

Map No. _____ Sec. 16 Twp. 28 R. 4
 Well No. 16 Farmer Farm
Empire Company

NORTH

WEST

EAST

SOUTH

Location _____

Rig Up _____

Drilling and remarks

RECORD

Cased _____ in. _____ Ft.

Sand _____

Gas _____

Oil _____

Total Depth _____

PRODUCTION

1st 24 hrs. Nat. _____

1st 24 hrs. after shot _____

Gas _____ Cu. Ft.

Dry Hole _____

Abandoned _____

Date

3/12, 1912 2 Carley Scout

Map No. _____ Sec. 16 Twp. 28 R. 4Well No. 16 Varner FarmEmpire Company

NORTH

WEST

EAST

SOUTH

Location _____

Rig Up _____

Drilling and remarks

2080'

RECORD

Cased _____ in. _____ Ft.

Sand _____

Gas _____

Oil _____

Total Depth _____

PRODUCTION

1st 24 hrs. Nat. _____

1st 24 hrs. after shot _____

Gas _____ Cu. Ft.

Dry Hole _____


Abandoned _____

Date

3/19, 1917 C. Cordeff Scout

Map No. _____ Sec. 16 Twp. 28 R. 4
 Well No. 16 Farmer Farm _____
Empire Company _____

NORTH

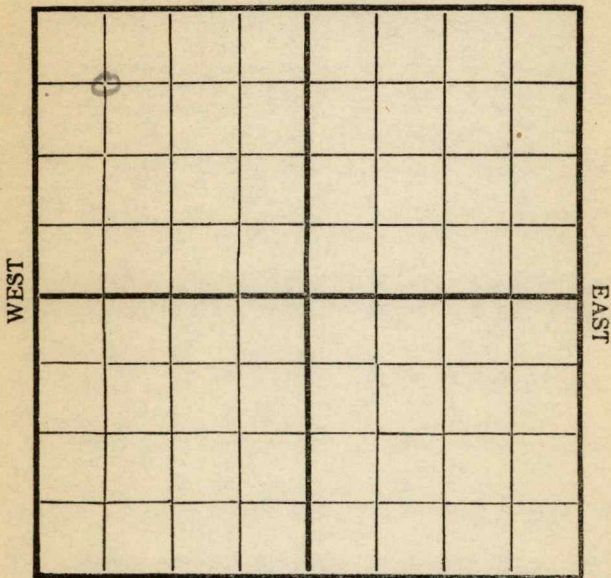

SOUTH

Location _____
 Rig Up _____
 Drilling and remarks _____

2280'

RECORD

Cased _____ in. _____ Ft.
 Sand _____
 Gas _____
 Oil _____
 Total Depth _____

PRODUCTION

1st 24 hrs. Nat. _____
 1st 24 hrs. after shot _____
 Gas _____ Cu. Ft.
 Dry Hole _____
 Abandoned _____

Date

3/36, 191 7 Land Scout

Map No. _____ Sec. 16 Twp. 28 R. 4
 Well No. 16 Varner Farm
Cummins Company

NORTH

WEST

EAST

SOUTH

Location _____

Rig Up _____

Drilling and remarks

Tap sand
2525'

RECORD

Cased _____ in. _____ Ft.

Sand _____

Gas _____

Oil _____

Total Depth _____

PRODUCTION

1st 24 hrs. Nat. _____

First 24 hrs. after shot _____

Gas _____ Cu. Ft.

Dry Hole _____

Abandoned _____

Date

4/4, 191 7. Condit Scout

Map No. K11 Sec. 16 Twp. 28 R. 4Well No. 16 VarnerCuywire & Co Company

Contractor

NORTH

WEST

EAST

SOUTH

COMPLETED

Location _____

Rig up _____

Drilling and Remarks:

Top sand
2575' fr
Estimated at
60300

RECORD

Cased _____ in., _____ ft.

Sand 2492-2496

Gas _____

Oil _____

Total Depth _____

PRODUCTION

1st 24 hrs. Nat. _____

1st 24 hrs. after shot _____

Gas _____ Cu. Ft.

Dry Hole _____

Abandoned _____

Date

4/4 4/11/1917
191 Cardiff Scout