

O.W.N.O.

KANSAS

Cowley


Section 22 Township 34 Range 3-E

Well No. #1 Palmer

Company ABSHER + BOOTH  
~~Ryan Consolidated~~

~~Wildcat~~

HARVEY POOL NORTH

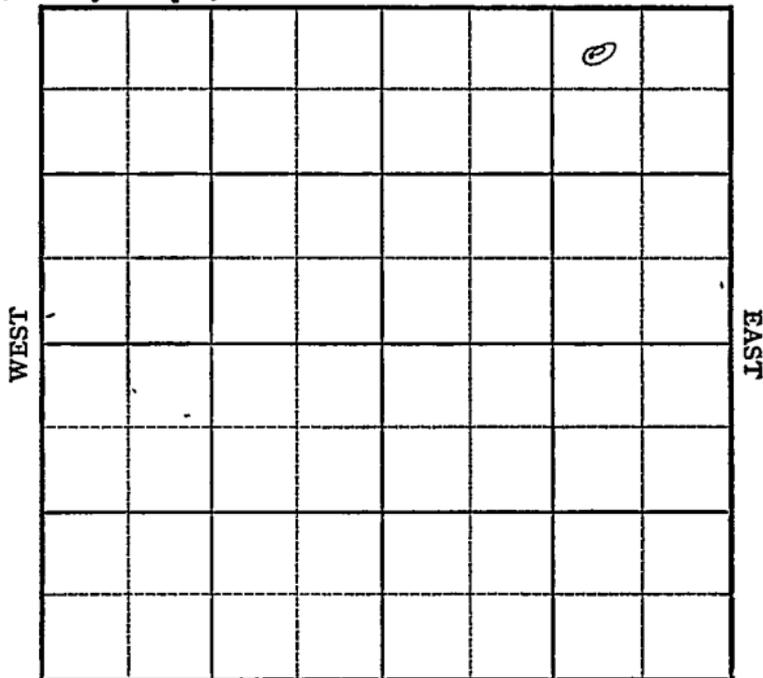

SOUTH

**O.W.W.O.**

Cowley **KANSAS** ✓

Sec. 22 Twp. 34 R. 3E ✓

Well No. #1 Palmer Farm

~~ROSMER & BOOTH~~  
~~Ryan Consolidated~~

Company

~~SPRINGERY HARPER~~  
~~Watson Drlg.~~

Contractor


~~Wildcat HARVEY POOL~~

330' Ft. from N. Line

\_\_\_\_\_ Ft. from S. Line

990' Ft. from E. Line

\_\_\_\_\_ Ft. from W. Line

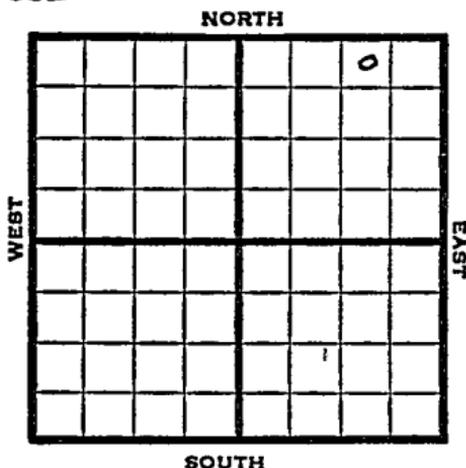

NW NE NE

1949

Elev 1075' REPORT

11/9 Location

11/16 "

11/23 8" @ 106'  
Drlg. 1825'

11/30 TD 3286'  
Bart 3242'  
Aband.

**ABANDONED**

**O.W.W.O.**

1952

12/17 Layton 2580, KC 2695, Bart  
3242'  
OTD 3286  
DD 3303  
5" @ 3302'

1953

1/23 Oil well TD 3303' Layton 2580'  
KC 2695' Bart 3242' OTD 3286  
DD 3303 5" @ 3302 GO to 3300  
70/3271-84 S/1½ BO ½ BWPH PB 3280  
Hydro.  
Comp. BHB 1842 BOPD

**COMPLETED**

Map No. \_\_\_\_\_ Sec. 22 Twp. 34 R. 3E

Well No. 1 Palmer

Ryan Consolidated Company

Watson Drlg. Contractor

NW NE NE

FIRST REPORT  
SECTION PLAT

330 Ft. from N. Line

\_\_\_\_\_ Ft. from S. Line

990 Ft. from E. Line

\_\_\_\_\_ Ft. from W. Line


Cowley County

RECORD

Location X

Cased \_\_\_\_\_ in., \_\_\_\_\_ ft.

Rig up \_\_\_\_\_

Sand \_\_\_\_\_

Drilling and Remarks: \_\_\_\_\_

Gas \_\_\_\_\_

Oil \_\_\_\_\_

Total Depth \_\_\_\_\_

PRODUCTION

1st 24 hrs. Nat. \_\_\_\_\_

1st 24 hrs. after shot \_\_\_\_\_

Gas \_\_\_\_\_ Cu. Ft.

Dry Hole \_\_\_\_\_

Abandoned \_\_\_\_\_

Date

NOV 9 1949 19

S. J. LEWIS Scout

Map No. \_\_\_\_\_ Sec. 22 Twp. 34 R. 3E

Well No. 1 Palmer

\_\_\_\_\_ Ryan Consolidated \_\_\_\_\_ Company

**ABANDONED**

\_\_\_\_\_ NW NE NE \_\_\_\_\_ Contractor

*E. I. 1075*  
 SECTION PLAT

330 Ft. from N. Line

\_\_\_\_\_ Ft. from S. Line

990 Ft. from E. Line

\_\_\_\_\_ Ft. from W. Line

			o

Cowley County

Location \_\_\_\_\_

Rig up \_\_\_\_\_

Drilling and Remarks:

*Bar 3242*

**RECORD**

Cased \_\_\_\_\_ in., \_\_\_\_\_ ft.

Sand \_\_\_\_\_

Gas \_\_\_\_\_

Oil \_\_\_\_\_

Total Depth 13286

**PRODUCTION**

1st 24 hrs. Nat. \_\_\_\_\_

1st 24 hrs. after shot \_\_\_\_\_

Gas \_\_\_\_\_ Cu. Ft.

Dry Hole \_\_\_\_\_

Abandoned \_\_\_\_\_

Date

NOV 30 1949

S. I. LEWIS

Scout

# O.W.W.O.

County Cowley State Kansas  
 Sec. 22 (Blk.) 34 (Sur.) 3E Map No.  
 Operator Absher & Booth (was Ryan Consolidate  
 Well No. 1 Farm Palmer  
 Elev. 1075 Location NW NE NE

					0

330 Ft. From N Line NE  
990 Ft. From E Line Quarter  
 Ist. Report DEC 17 1952  
 Completion O.W.W.O.  
 Remarks (O.W.W.O.)  
Springer & Harper - Contr.  
 Spudding Date

Drilg. Data Harvey Pool  
Layton 2580 KC 2695 Bart. 3242  
OTD 3286 DD 3303 5" @ 3302

