

Map No. R11 Sec. 16 Twp. 28 R. 4Well No. 18 Varner Farm
Empire Company

NORTH

WEST

EAST

SOUTH

COMPLETED

Location -----

Rig Up -----

Drilling Remarks:

Drilling Remarks:

RECORD

PRODUCTION

Cased ----- in ----- Ft.

1st 24 hrs. Nat. -----

Sand -----

1st 24 hrs. after shot -----

Gas -----

Gas ----- Cu. Ft.

Oil -----

Dry Hole -----

Total Depth -----


Abandoned -----

Map No. K11 Sec. 16 Twp. 28 R. 4
 Well No. 18 Varner Farm
Engine Company

NORTH

WEST

EAST

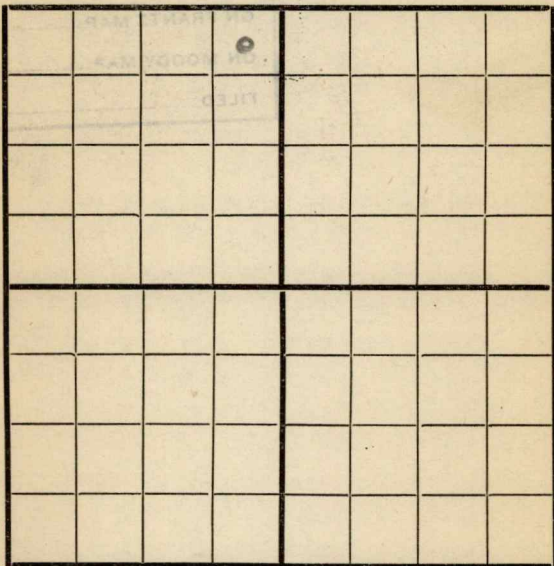

SOUTH

Location _____
 Rig Up ☒ _____
 Drilling and remarks _____

RECORD

Cased _____ in. _____ Ft.
 Sand _____
 Gas _____
 Oil _____
 Total Depth _____

PRODUCTION

1st 24 hrs. Nat. _____
 1st 24 hrs. after shot _____
 Gas _____ Cu. Ft.
 Dry Hole _____
 Abandoned _____

FIRST REPORT

Date


4/24, 1917 Conroy Scout

Map No. _____ Sec. 16 Twp. 28 R. 4
 Well No. 18 Warner Farm _____
Engine Company _____

NORTH

WEST

EAST

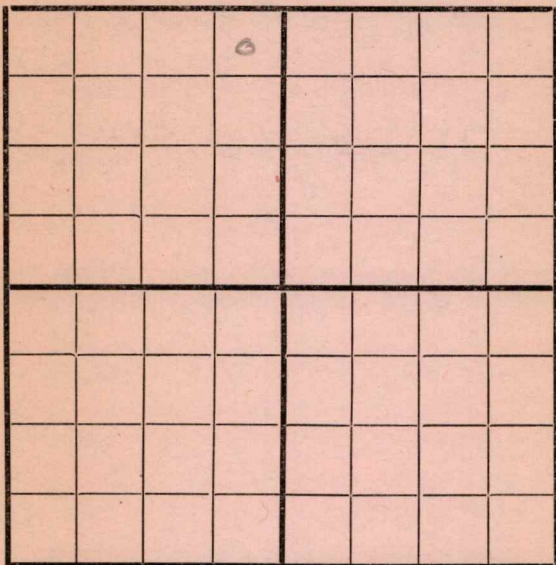

SOUTH

Location _____
 Rig Up _____
 Drilling and remarks _____

RECORD

Cased _____ in. _____ Ft.
 Sand _____
 Gas _____
 Oil _____
 Total Depth _____


PRODUCTION

1st 24 hrs. Nat. _____
 1st 24 hrs. after shot _____
 Gas _____ Cu. Ft.
 Dry Hole _____
 Abandoned _____

Date 5/2, 1917 Andy Scout

Map No. _____ Sec. 16 Twp. 28 R. 4
 Well No. 18 Varner Farm _____
Engine Company _____

NORTH

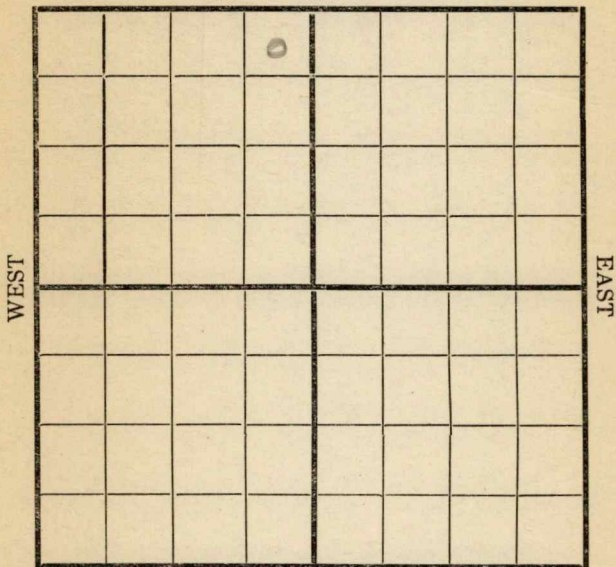

SOUTH

Location _____

Rig Up _____

Drilling and remarks _____

RECORD

Cased _____ in. _____ Ft.

Sand _____

Gas _____

Oil _____

Total Depth _____

PRODUCTION

1st 24 hrs. Nat. _____

1st 24 hrs. after shot _____

Gas _____ Cu. Ft.

Dry Hole _____

Abandoned _____

Date

5/8, 1917 Conley Scout

Map No. _____ Sec. 16 Twp. 28 R. 4Well No. 18 Varner Farm __________
Cummins Company _____

NORTH

WEST

EAST

SOUTH

Location _____

Rig Up _____

Drilling and remarks

825

RECORD

Cased _____ in. _____ Ft.

Sand _____

Gas _____

Oil _____

Total Depth _____

PRODUCTION

1st 24 hrs. Nat. _____

1st 24 hrs. after shot _____

Gas _____ Cu. Ft.

Dry Hole _____

Abandoned _____

Date


5/25, 191 7 Conkey Scout

Map No. _____ Sec. 16 Twp. 28 R. 4
Well No. 18 Farmer Farm
Engine Company

NORTH

WEST

EAST

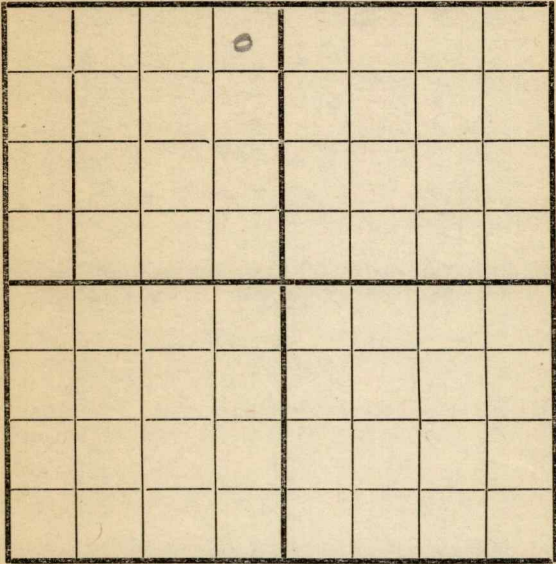

SOUTH

	RECORD
Location _____	Cased _____ in. _____ Ft.
Rig Up _____	Sand _____
Drilling and remarks <u>1326</u>	Gas _____
	Oil _____
	Total Depth _____
	PRODUCTION
	1st 24 hrs. Nat. _____
	1st 24 hrs. after shot _____
	Gas _____ Cu. Ft.
	Dry Hole _____
	Abandoned _____


Date 5/29 1917 Cardiff Scout

Map No. _____ Sec. 16 Twp. 28 R. 4
 Well No. 18 Varner Farm
Engine Company

NORTH

WEST

EAST

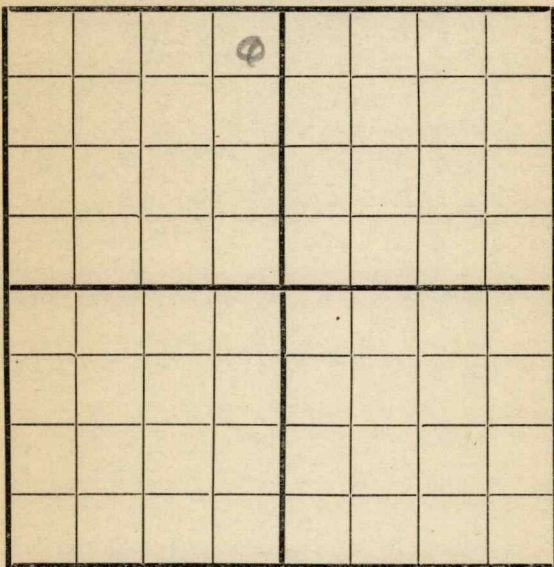

SOUTH

Location _____

Rig Up _____

Drilling and remarks

RECORD

Cased _____ in. _____ Ft.

Sand _____

Gas _____

Oil _____

Total Depth _____

PRODUCTION

1st 24 hrs. Nat. _____

1st 24 hrs. after shot _____

Gas _____ Cu. Ft.

Dry Hole _____

Abandoned _____

Date

6/8, 1917 Cardiff Scout

Map No. _____ Sec. 16 Twp. 28 R. 4Well No. 18 Farm _____ FarmEngine Company _____

NORTH

			0				

WEST

EAST

SOUTH

Location _____

Rig Up _____

Drilling and remarks

2210

RECORD

Cased _____ in. _____ Ft.

Sand _____

Gas _____

Oil _____

Total Depth _____

PRODUCTION

1st 24 hrs. Nat. _____

1st 24 hrs. after shot _____

Gas _____ Cu. Ft.

Dry Hole _____

Abandoned _____

Date

6/12, 1917 Candley Scout

Map No. _____ Sec. 16 Twp. 28 R. 4
 Well No. 18 corner Farm _____
 _____ Company _____

NORTH

WEST

EAST

COMPLETED

SOUTH

Location _____
 Rig Up _____
 Drilling and remarks _____

Est at 60
1366

RECORD

Cased _____ in. _____ Ft.
 Sand 2496-2508
 Gas _____
 Oil _____
 Total Depth _____

PRODUCTION

1st 24 hrs. Nat. _____
 1st 24 hrs. after shot _____
 Gas _____ Cu. Ft.
 Dry Hole _____
 Abandoned _____

Date

6/30, 1917 Conley Scout