


Section 3 Township 18 Range 8-W

#6 A LENSEN

Well Number ~~#1 Jansen "C"~~

Company Empire

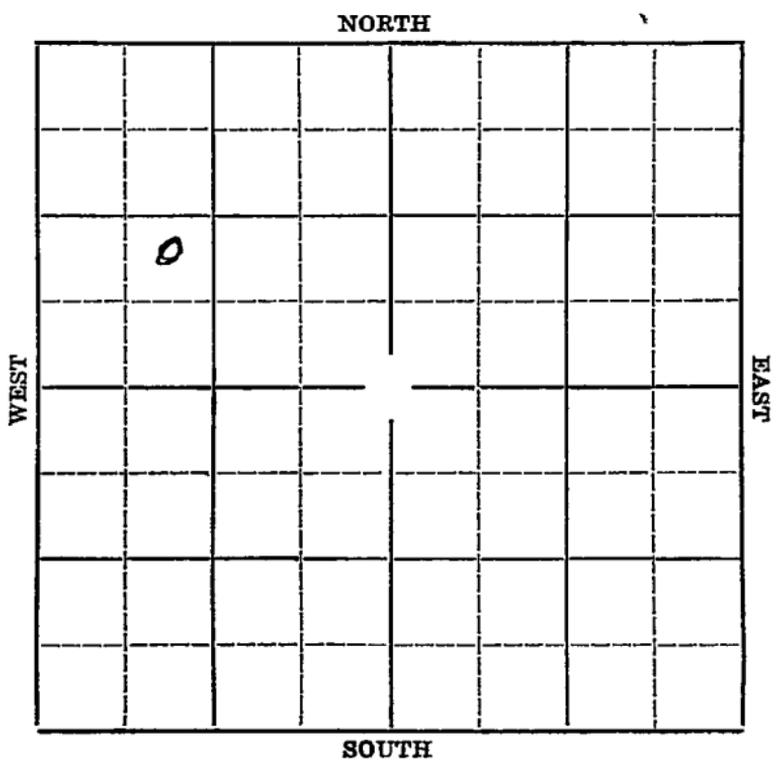

Map No. KANSAS Sec. 3 Twp. 18 R. 8W

Well No. ~~#1 Jansen "C"~~ 6 "A" Jansen Farm

Empire

Company


_____ Ft. from N. Line

990' Ft. from S. Line

_____ Ft. from E. Line

990' Ft. from W. Line

Elev. 1777

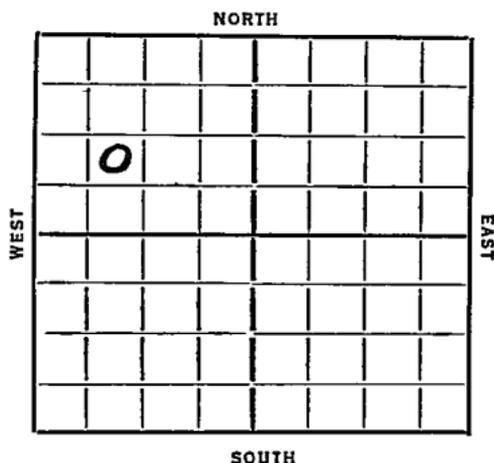

Date
1936

REPORT

8/12 Location

8/20 15" @ 216' drlg.

8/27 Drlg. 1643'.

9/3 Drlg. 2845'.

9/30/36-Sil. 3238'.

T.D. 3272'.

2000 gallons of acid.

Potential 986 bbls of oil.

COMPLETED

Rice
Map No. 45 Sec. 3 Twp. 18 R. 8W

Well No. Jonson "C"

Empire Company

Contractor

SECTION PLAT

0			

_____ Ft. from N. Line

990 Ft. from S. Line

_____ Ft. from E. Line

990 Ft. from W. Line

Location ✓

Rig up _____

Drilling and Remarks:

RECORD

Cased _____ in., _____ ft.

Sand _____

Gas _____

Oil _____

Total Depth _____

PRODUCTION

1st 24 hrs. Nat. _____

1st 24 hrs. after shot _____

Gas _____ Cu. Ft.

Dry Hole _____

Abandoned _____

Date

AUG 12 1936 19

S. J. LEWIS Scout

Map No. 45 Sec. 3 Twp. 18 R. SW.

Well No. 67 Jansen

Engineer Company

Contractor

SECTION PLAT

0			

_____ Ft. from N. Line

990 Ft. from S. Line

_____ Ft. from E. Line

990 Ft. from W. Line

CORRECTION

Location completed well

Rig up _____

Drilling and Remarks:

*Reported by
Jansen "C"*

RECORD

Cased _____ in., _____ ft.

Sand _____

Gas _____

Oil _____

Total Depth _____

PRODUCTION

1st 24 hrs. Nat. _____

1st 24 hrs. after shot _____

Gas _____ Cu. Ft.

Dry Hole _____

Abandoned _____

Date

SEP 30 1936 19

S. J. LEWIS

Scout

Map No. 45 Sec. 2 Twp. 18 R. SW.

Well No. 67

Emilee Company

Contractor

SECTION PLAT

	0		

_____ Ft. from N. Line

990 Ft. from S. Line

_____ Ft. from E. Line

990 Ft. from W. Line

COMPLETED

Location _____

Rig up _____

Drilling and Remarks:

Sl 3238
2000 acid
P 9986.

RECORD

Cased _____ in., _____ ft.

Sand _____

Gas _____

Oil _____

Total Depth 3272

PRODUCTION

1st 24 hrs. Nat. _____

1st 24 hrs. after shot _____

Gas _____ Cu. Ft.

Dry Hole _____

Abandoned _____

Date

SEP 30 1936

19

S. J. LEWIS

Scout