
KANSAS
Form 51—5M—4-36—Palace

Rice

Section 3 Township 18 Range 8-W

Well Number #7 Jansen "A"

Company Empire

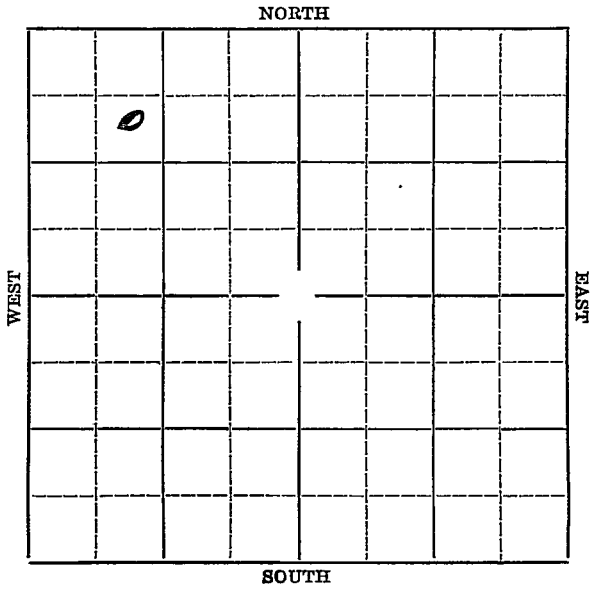

Form 252-A—5M—7-36—Palace

KANSAS

Rice

Sec. 3 Twp. 18 R. 8W

Well No. #7 Jansen "A" Farm

Empire Company


990' Ft. from N. Line

Ft. from S. Line

Ft. from E. Line

990' Ft. from W. Line

Elev. 1776

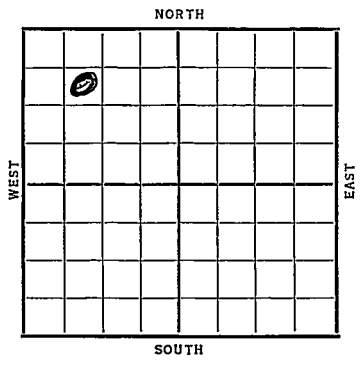

Date 1936	REPORT
9/30	Location.
10/8--	
10/15	Rigging up.
10/22	10" @ 205'. Drlg. 1655'.
10/29	Drlg. 3195'.
11/6	Sil. 3227 7" @ 3228 WOC
11/12	T. D. 3257 3000 acid. No test.
11/18	Sil. 3227 T. D. 3257
	3000 acid. Pot. 856
	COMPLETED

Form 26—1M Bks.—2-29

KANSAS

Rice


Map No. 45 Sec. 3 Twp. 18 R. 5W

Well No. 7 James "A"

Eldjurz Company

Contractor

SECTION PLAT

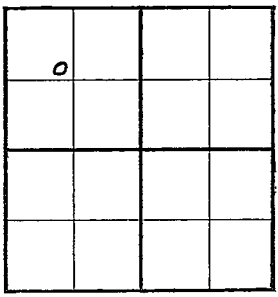

990 Ft. from N. Line

_____ Ft. from S. Line

_____ Ft. from E. Line

990 Ft. from W. Line

FIRST REPORT

Location ✓

Rig up _____

Drilling and Remarks:

RECORD

Cased _____ in., _____ ft.

Sand _____

Gas _____

Oil _____

Total Depth _____

PRODUCTION

1st 24 hrs: Nat. _____

1st 24 hrs. after shot _____

Gas _____ Cu. Ft.

Dry Hole _____

Abandoned _____

Date

SEP 30 1936 19 S. J. LEWIS Scout

Form 26 ~~M~~ Bks.—2-29 KANSAS


Map No. 45 Sec. 3 Twp. 18 R. 8W.

Well No. 7 Jansen "A"

Eaton Lease Company

Contractor

SECTION PLAT

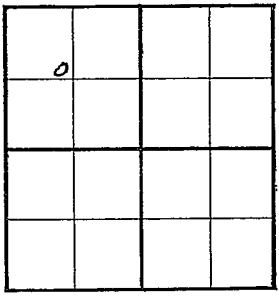

990 Ft. from N. Line

Ft. from S. Line

Ft. from E. Line

990 Ft. from W. Line

COMPLETED

Location

Rig up

Drilling and Remarks:

Si 03227

3000 acid

P & J. 856

RECORD

Cased in., ft.

Sand

Gas

Oil

Total Depth 3257

PRODUCTION

1st 24 hrs. Nat.

1st 24 hrs. after shot

Gas Cu. Ft.

Dry Hole

Abandoned

Date

NOV 18 1936 19

S. J. LEWIS Scout