


Section 3 Township 18 Range 8W

Well No. #1 Janssen

Company Raymond-Lebow & Musgrove Pet.

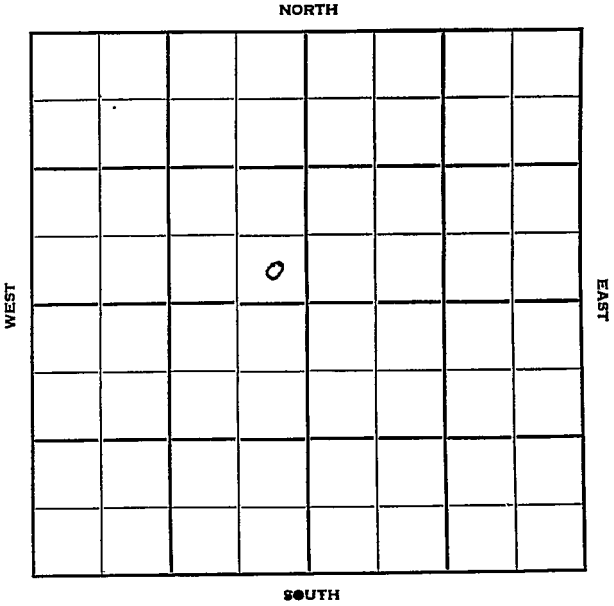

Rice

KANSAS
8W

Sec. 3 Twp. 18 R. 8W ✓ ✓

Well No. #1 Janssen Farm

Raymond-Lebow & Musgrove Pet. Company

Edwards Pool Contractor


Ft. from N. Line

230' Ft. from S. Line

330' Ft. from E. Line

Ft. from W. Line

SE SE NW (Twin Well)

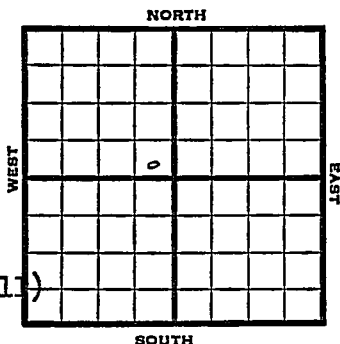

1951 Elev. 1778' REPORT

6/6 Spud 6-2-51
10" @ 251
Anhy 480-550
Drlg. 1325

6/27 Spud 6-2-51
D&A TD 3285
10" @ 251
Anhy 480-550 Lans. 2846
Cong. 3222
DST 3223-30 opn 1 hr
Rec. 740' o & gcmw & 70' wtr
Arb. 3255 TD 3260
5" @ 3254 1300 A DD 3285
D&A

ABANDONED

County **Rice** State **Kansas**

Sec. **3** (Blk.) **18** (Sur.) **8W** Map No.

Operator Raymond-Lebow & Mungrove Pet.

Well No. **1** Farm **Janssen**

Elev.	Location	SE SE NW	(twin well)
-------	----------	-----------------	--------------------

230 Ft. From S Line NW

330 Ft. From E Line Quarter

1st. Report JUN 6 1951

Completion

Remarks

Penguin Drlg. - Contr.


Spudding Date **6-2-51**

Drlg. Data Edwards Pool

10" @ 251 Anhy 480-550 ' drlg. 1325

J. F. TVRA

County Rice State Kansas
 Sec. 3 (Blk.) 18 (Sur.) 8W Map No.
 Operator Raymond - Lebow & Musgrove Pet.
 Well No. 1 Farm Janssen
 Elev. 1778 Location SE SE NW

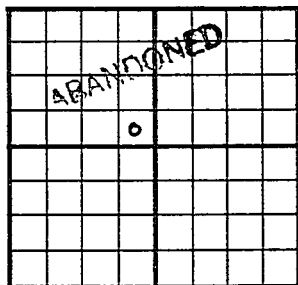

230 Ft. From S Line NW
330 Ft. From E Line Quarter

1st. Report

Completion JUN 27 1951

Remarks Edwards Pool

Penguin Drlg. - Contr.

Spudding Date 6-2-51

Drlg. Data D & A TD 3285

10" @ 251 Anhy 480-550 Lans. 2846

Cong. 3222 DST 3223-30 open 1 hr.

Rec. 740' o & gcmw & 70' water Arb. 3255

TD 3260 5" @ 3254 1300 A DD 3285

D & A