


Map No. _____ Sec. 16 Twp. 28 R. 4
Well No. 13 E.C. Warner Farm
Empire Company
NORTH

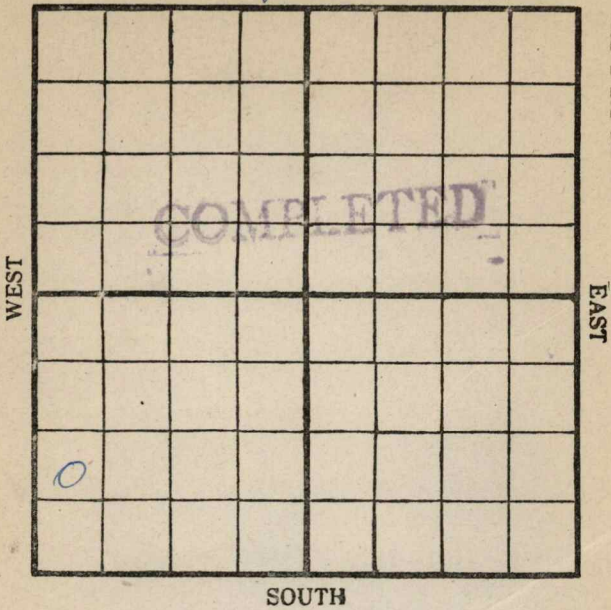

Location _____

Rig Up _____

Drilling Remarks:

Drilling Remarks:

RECORD

PRODUCTION

Cased _____ in. _____ ft.
Sand _____
Gas _____
Oil _____
Total Depth _____


1st 24 hrs. Nat. _____
1st 24 h's. after shot _____
Gas _____ cu. ft
Dry Hole _____
Abandoned _____

Map No. _____ Sec. 16 Twp. 28 R. 4
 Well No. 13 CC Rammer Farm _____
 _____ Company

NORTH

WEST

EAST

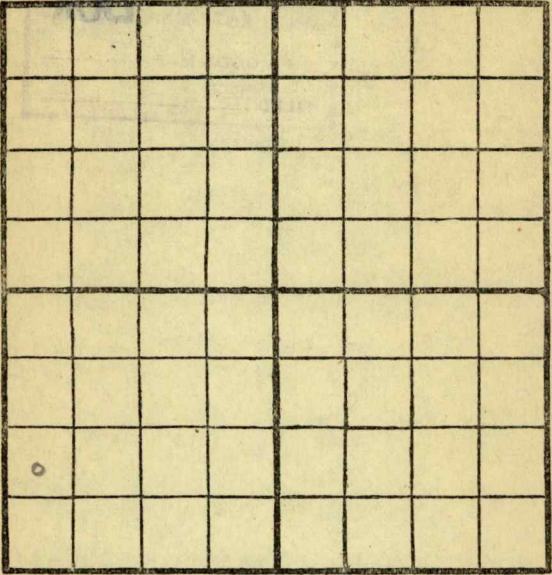

SOUTH

Location _____

Rig Up ☒ _____

Drilling and remarks

RECORD

Cased _____ in. _____ Ft.

Sand _____

Gas _____

Oil _____

Total Depth _____

PRODUCTION

1st 24 hrs. Nat. _____

1st 24 hrs. after shot _____

Gas _____ Cu. Ft.

Dry Hole _____

Abandoned _____

FIRST RECORD

Date


9/19, 1917, Conley Scout

Map No. _____ Sec. 16 Twp. 28 R. 4

Well No. 13 Turner Farm _____
Empire Company

NORTH

WEST

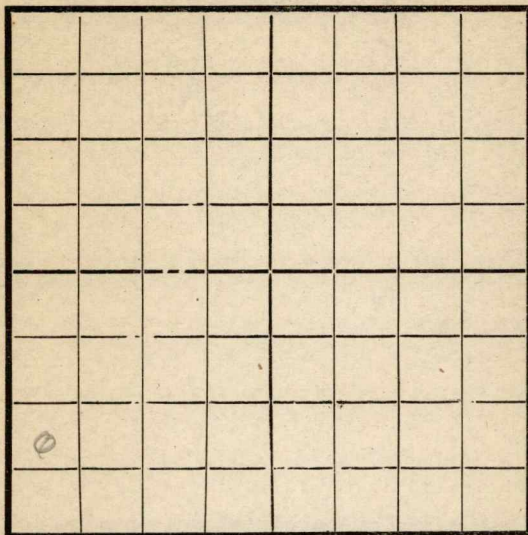

EAST

SOUTH

Location _____

Rig Up _____

Drilling and remarks

2325

RECORD

Cased _____ in. _____ Ft.

Sand _____

Gas _____

Oil _____

Total Depth _____

PRODUCTION

1st 24 hrs. Nat. _____

1st 24 hrs. after shot _____

Gas _____ Cu. Ft.

Dry Hole _____


Abandoned _____

Date

10/5, 1917 Cardiff Scout

Map No. _____ Sec. 16 Twp. 28 R. 4
 Well No. 13 Farmer Farm _____
Engine Company _____
 NORTH

WEST

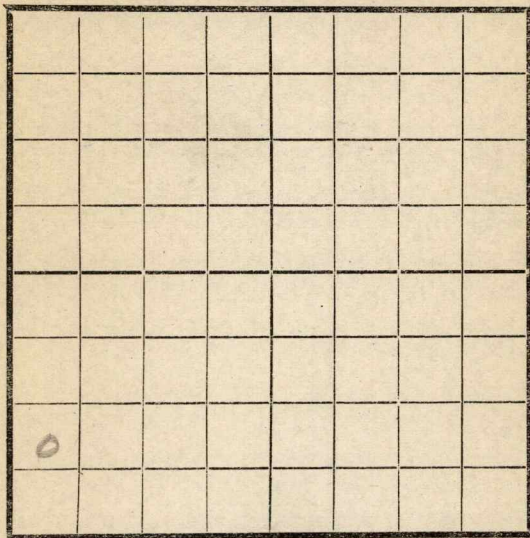

EAST

SOUTH

Location _____
 Rig Up _____
 Drilling and remarks

560

RECORD

Cased _____ in. _____ Ft.
 Sand _____
 Gas _____
 Oil _____
 Total Depth _____

PRODUCTION

1st 24 hrs. Nat. _____
 1st 24 hrs. after shot _____
 Gas _____ Cu. Ft.
 Dry Hole _____
 Abandoned _____


Date

10/9, 1917 Carley Scout

Map No. _____ Sec. 16 Twp. 28 R. 4Well No. 13 Farm _____Engine Company _____

NORTH

WEST

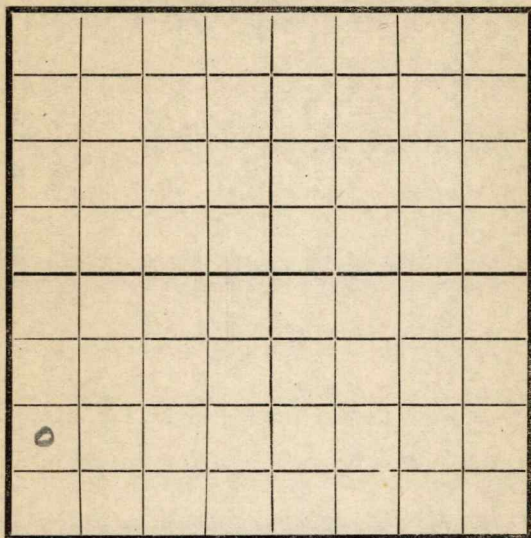

EAST

SOUTH

Location _____

Rig Up _____

Drilling and remarks

745-

RECORD

Cased _____ in. _____ Ft.

Sand _____

Gas _____

Oil _____

Total Depth _____

PRODUCTION

1st 24 hrs. Nat. _____

1st 24 hrs. after shot _____

Gas _____ Cu. Ft.

Dry Hole _____

Abandoned _____

Date


10/17, 1912 Carley Scout

Map No. _____ Sec. 16 Twp. 28 R. 4Well No. 13 _____ Farm _____

_____ Company _____

NORTH

WEST

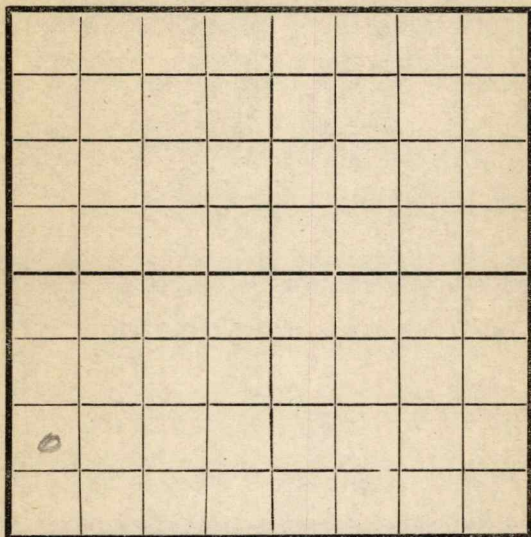

SOUTH

Location _____

Rig Up _____

Drilling and remarks

1365

RECORD

Cased _____ in. _____ Ft.

Sand _____

Gas _____

Oil _____

Total Depth _____

PRODUCTION

1st 24 hrs. Nat. _____

1st 24 hrs. after shot _____

Gas _____ Cu. Ft.

Dry Hole _____

Abandoned _____


Date

10/24, 1917 Candiff Scout

Map No. _____ Sec. 16 Twp. 28 R. 4Well No. 13 Harmon Farm
Engine Company

NORTH

WEST

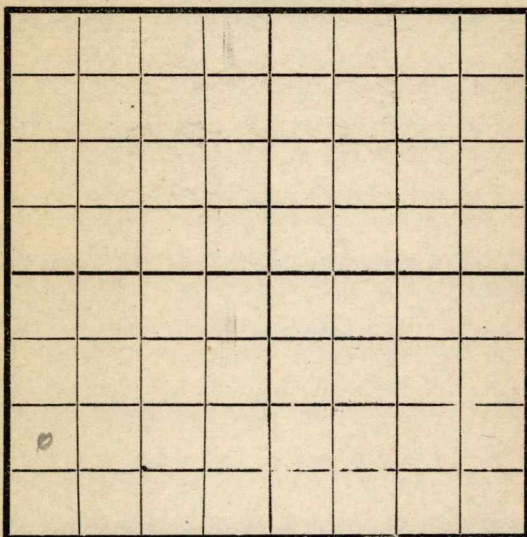

EAST

SOUTH

Location _____

Rig Up _____

Drilling and remarks

1402

RECORD

Cased _____ in. _____ Ft.

Sand _____

Gas _____

Oil _____

Total Depth _____

PRODUCTION

1st 24 hrs. Nat. _____

1st 24 hrs. after shot _____

Gas _____ Cu. Ft.


Dry Hole _____

Abandoned _____

Date

10/31, 1917 Carl J. Scout

Map No. _____ Sec. 16 Twp. 28 R. 4
Well No. 13 Frank Farm _____
Engine Company _____
NORTH

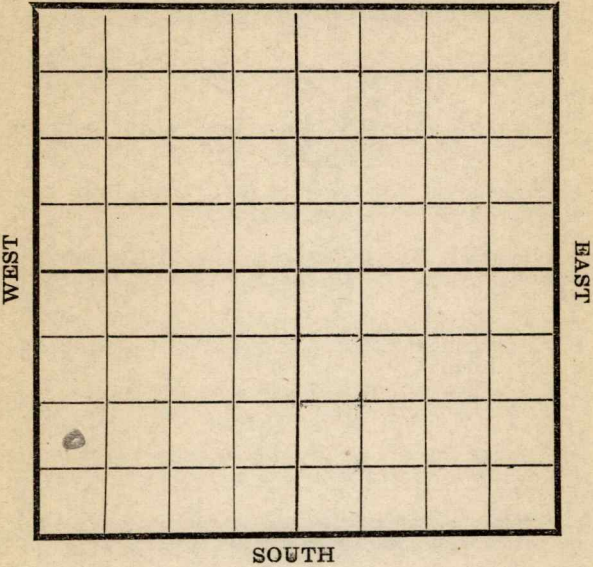

	RECORD
Location _____	Cased _____ in. _____ Ft.
Rig Up _____	Sand _____
Drilling and remarks	Gas _____
<u>SD</u> <u>1402</u>	Oil _____
	Total Depth _____
	PRODUCTION
	1st 24 hrs. Nat. _____
	1st 24 hrs. after shot _____
	Gas _____ Cu. Ft.
	Dry Hole _____
	Abandoned _____

Date 11-7, 1917 Carly Scout _____


Map No. _____ Sec. 16 Twp. 28 R. 4

Well No. 13 Harrier Farm _____

Empire Company _____

NORTH

WEST

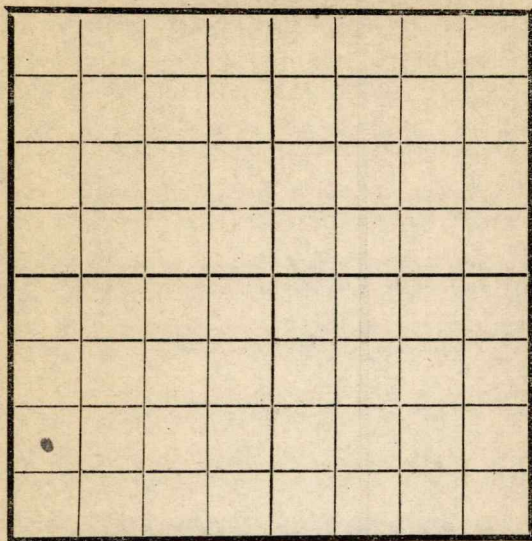

EAST

SOUTH

Location _____

Rig Up _____

Drilling and remarks

1655

RECORD

Cased _____ in. _____ Ft.

Sand _____

Gas _____

Oil _____

Total Depth _____

PRODUCTION

1st 24 hrs. Nat. _____

1st 24 hrs. after shot _____

Gas _____ Cu. Ft.

Dry Hole _____

Abandoned _____

Date

11/14, 1917 Conley Scout

Map No. _____ Sec. 16 Twp. 38 R. 4


Well No. 13 varner Farm

Empire Company

NORTH

WEST

EAST

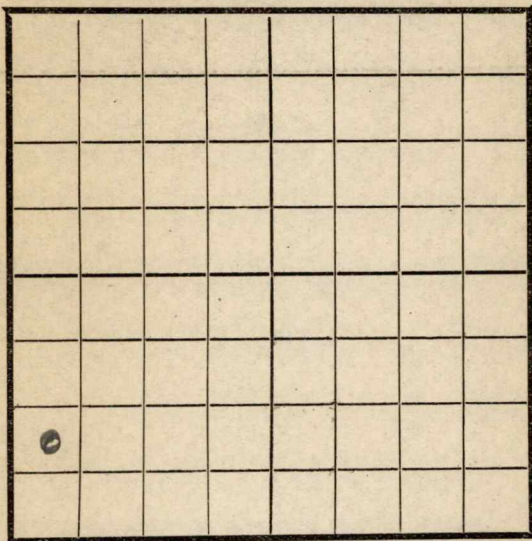

SOUTH

Location _____

Rig Up _____

Drilling and remarks

RECORD

Cased _____ in. _____ Ft.

Sand _____

Gas _____

Oil _____

Total Depth _____

PRODUCTION

1st 24 hrs. Nat. _____

1st 24 hrs. after shot _____

Gas _____ Cu. Ft.

Dry Hole _____

Abandoned _____


Date

11/21, 1917 Carly Scout

Map No. _____ Sec. 16 Twp. 28 R. 4
 Well No. 13 Farmer Farm _____
Engine Company _____

NORTH

WEST

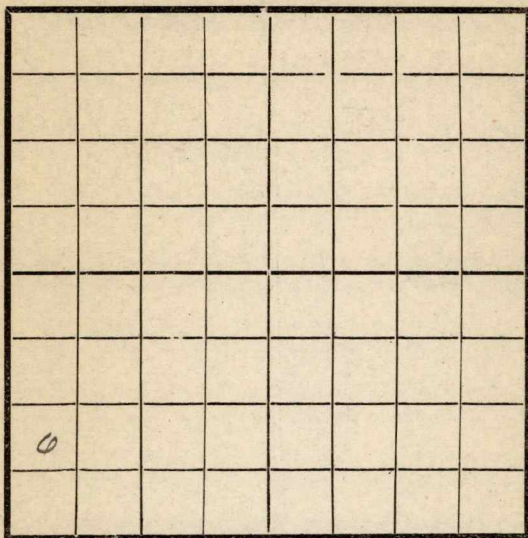

EAST

SOUTH

Location _____
 Rig Up _____
 Drilling and remarks

2237

RECORD

Cased _____ in. _____ Ft.
 Sand _____
 Gas _____
 Oil _____
 Total Depth _____

PRODUCTION

1st 24 hrs. Nat. _____
 1st 24 hrs. after shot _____
 Gas _____ Cu. Ft.
 Dry Hole _____
 Abandoned _____


Date

11/28, 1917 Cardiff Scout

Map No. _____ Sec. 16 Twp. 28 R. 4Well No. 13 Farmer _____ FarmEmpire _____ Company

NORTH

WEST

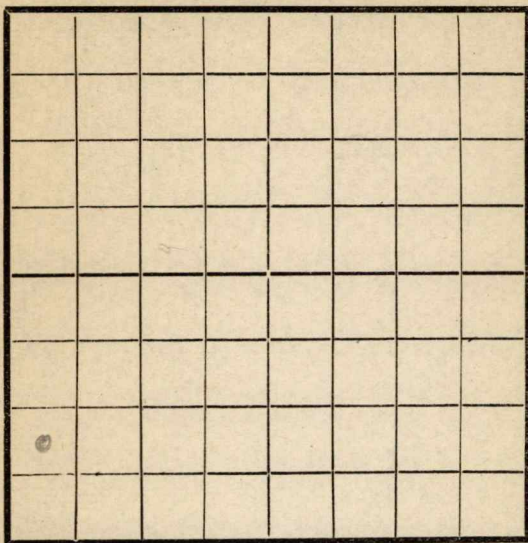

EAST

SOUTH

Location _____

Rig Up _____

Drilling and remarks

2425

RECORD

Cased _____ in. _____ Ft.

Sand _____

Gas _____

Oil _____

Total Depth _____

PRODUCTION

1st 24 hrs. Nat. _____

1st 24 hrs. after shot _____

Gas _____ Cu. Ft.

Dry Hole _____

Abandoned _____


Date

10/12, 1917 Empire _____ Scout

Map No. _____ Sec. 16 Twp. 28 R. 4Well No. 13 Harrier Farm __________
Company _____

NORTH

WEST

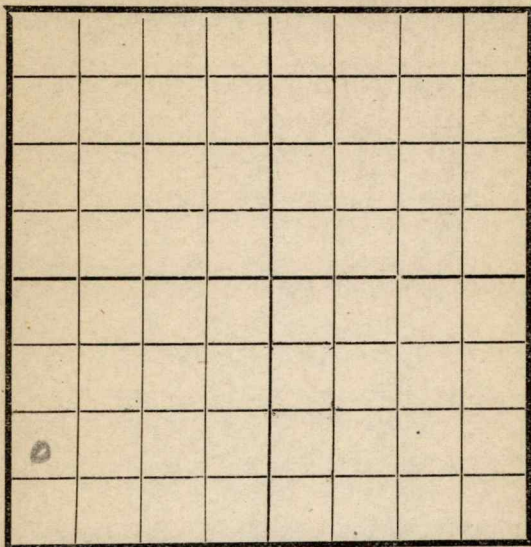

EAST

SOUTH

Location _____

Rig Up _____

Drilling and remarks

LD 2425

RECORD

Cased _____ in. _____ Ft.

Sand _____

Gas _____

Oil _____

Total Depth _____

PRODUCTION

1st 24 hrs. Nat. _____

1st 24 hrs. after shot _____

Gas _____ Cu. Ft.

Dry Hole _____

Abandoned _____


Date

13/19, 191 7 Caniff _____
Scout _____

Map No. _____ Sec. 16 Twp. 28 R. 4Well No. 13 Farmer Farm _____Empire Company _____

NORTH

WEST

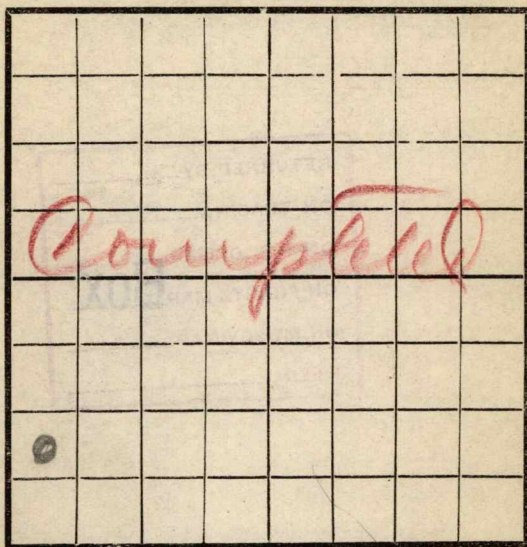

EAST

SOUTH

RECORD

Location _____

Rig Up _____

Drilling and remarks

Est at
70 Bbls

Cased _____ in. _____ Ft.

Sand 2446 - 2453

Gas _____

Oil _____

Total Depth _____

PRODUCTION

1st 24 hrs. Nat. _____

1st 24 hrs. after shot _____

Gas _____ Cu. Ft.

Dry Hole _____

Abandoned _____

Date

12/28, 1917 C. Conley Scout