KANSAS

Rice


FORM 51 IOM 12-46 PETROL

Section 3 Township 18 Range 8-W

Well No. 2 Jannsen

Company R. E. Williams

Edwards Pool

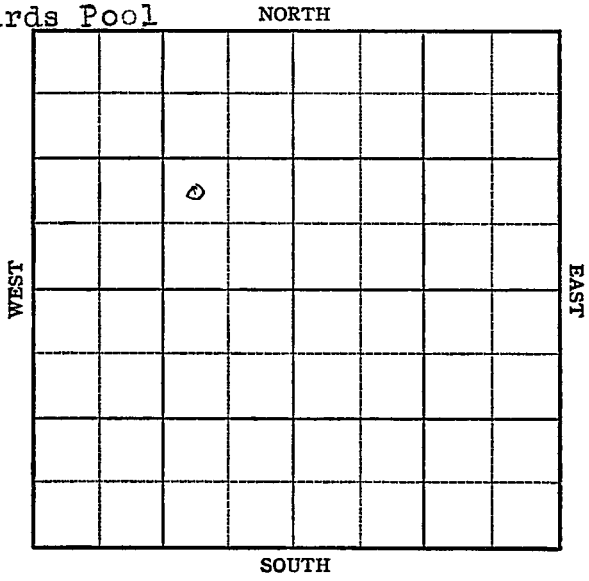

FORM 252-A
5M 9-47 PETROL

KANSAS Rice

Sec. 3 Twp. 18 R. 8W

Well No. #2 Janssen Farm

R. L. Williams Company

Edwards


Ft. from N. Line

990 Ft. from S. Line

990 Ft. from E. Line

Ft. from W. Line

NW SE NW

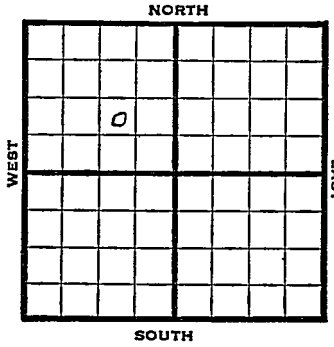

1947	Elev. 1776' REPORT
10/1	8" @ 200' Drlg. 1869'
10/8	Lansing 2835' BKC 3195' Simpson 3239' Arbuckle 3251' TD 3259' 5" @ 3254' RUST
10/15	TD 3281' 500 Acid
10/22	Swb 42 bbls oil in 17 hrs.
10/29	"
11/12	Arbuckle 3251' 5" @ 3254' 500 Acid Pump 202 Pot. Gr. 46° Total Depth 3281' COMPLETED

Form 26 200 Bks. 10-46 Petrol Kansas

Edwards Pool

Map No. ____ Sec. 3 Twp. 18 R. 8W


Well No. 2 Janssen

R. L. Williams Company

FIRST REPORT Contractor

NW SE NW

SECTION PLAT

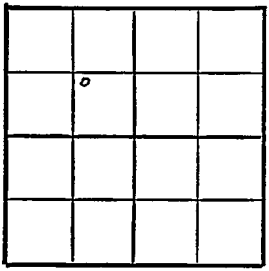

____ Ft. from N. Line

990 Ft. from S. Line

990 Ft. from E. Line

____ Ft. from W. Line

Rice County

Location ____

Rig up ____

Drilling and Remarks:

8" @ 200

drlg. 1869

RECORD

Cased ____ in., ____ ft.

Sand ____

Gas ____

Oil ____

Total Depth ____

PRODUCTION

1st 24 hrs. Nat. ____

1st 24 hrs. after shot ____

Gas ____ Cu. Ft.

Dry Hole ____

Abandoned ____

Date

OCT 1 1947 19 S. J. LEWIS Scout

Edwards Pool

Form 26 200 Bks. 10-46 Petrol
Kansas

Map No. 45 Sec. 3 Twp. 18 R. 8W

Well No. 2 Janssen


R. L. Williams Company

COMPLETE Contractor

NW SE NW

E.1726

SECTION PLAT

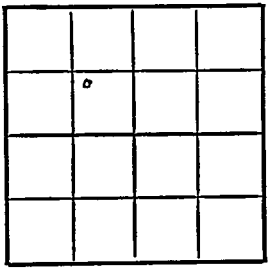

____ Ft. from N. Line

990 Ft. from S. Line

990 Ft. from E. Line

____ Ft. from W. Line

Rice County

Location

Rig up

Drilling and Remarks:

Cer & 3251

5' @ 3254

500 acid

Pump 202 BO

46 gr

RECORD

Cased ____ in., ____ ft.

Sand

Gas

Oil

Total Depth 3257

PRODUCTION

1st 24 hrs. Nat.

1st 24 hrs. after shot

Gas ____ Cu. Ft.

Dry Hole

Abandoned

Date

NOV 12 1947 19____

S. J. LEWIS Scout