


Section 27 Township 13 Range 14 W

Well No. # 2 Corwin

Company Trans-Era

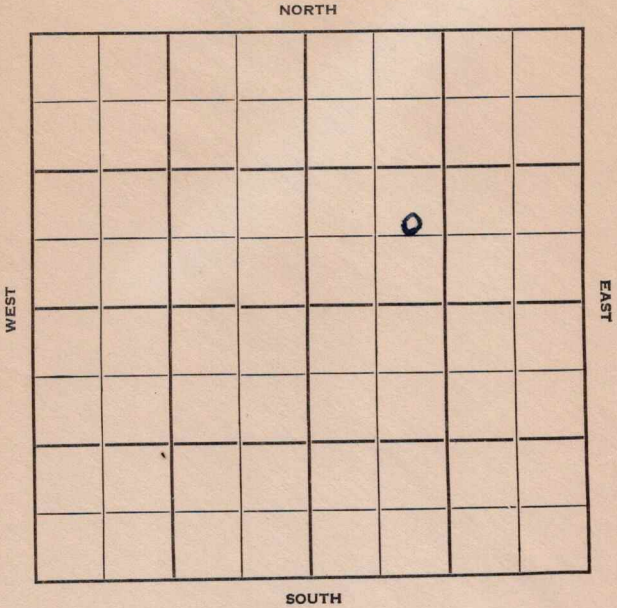

Russell

KANSAS



27

13

14W

Sec. _____ Twp. _____ R. _____

#2 Corwin

Well No. _____ Farm _____

Trans-Era

Company _____

Russell Pool

Contractor _____

1800

Ft. from N. Line


Ft. from S. Line

1650

Ft. from E. Line

Ft. from W. Line

NE SW NE

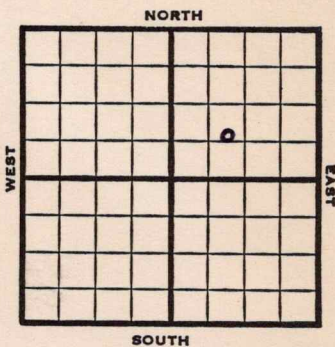

1953

Elev. 1831'

REPORT

4/15

Spud 4-9-53

8" @ 235

Anhy 835

Drlg. 1802'

4/23

Heeb 2926, Lans 2984

Drlg. 3240'

4/30

Arb. 3261

RTD 3263

5" @ 3262

5/6

Spud 4-9-53 Oil well TD 3268

8" @ 235 Anhy 835 Lans 2984

Heeb 2926 Arb 3261 TD 3263

5" @ 3262 DD 3268 500 A

S/20 BOPH

Comp. 50 BOPD

COMPLETED

