

Butler


FORM 51

KANSAS

Section 17 Township 28 Range 4E

Well No. #9 Haines

Company Morris Sitrin

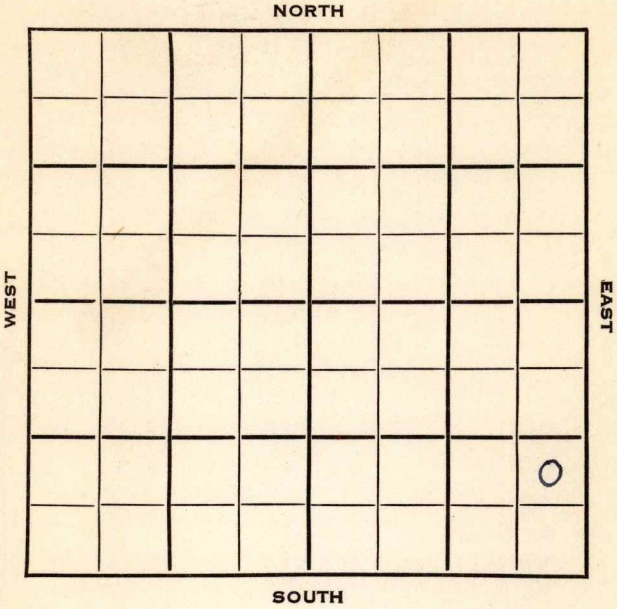

Butler

KANSAS

SEC.	TWP.	R.
17	28	4E

WELL NO. \_\_\_\_\_

9 Haines \_\_\_\_\_ FARM

COMPANY \_\_\_\_\_

CONTRACTOR **Morris Sitrin**

**H & M Drlg.**


**Augusta Pool**

\_\_\_\_\_ Ft. from N. Line

**725** \_\_\_\_\_ Ft. from S. Line

**440** \_\_\_\_\_ Ft. from E. Line

\_\_\_\_\_ Ft. from W. Line

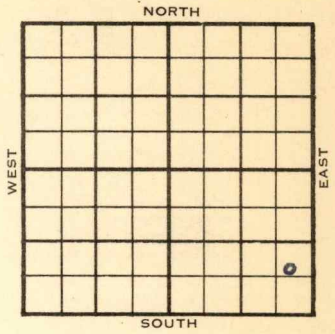

NE SE SE

1953	ELEVATION <b>1207'</b>	REPORT
------	---------------------------	--------

9/23 MIR

10/14 Spud -  
Oil Well  
TD 2452'  
**Simp 2448'**  
TD 2451'  
5" @ 2448'  
**Arb 2448'**  
DD 2452'  
Comp 14 bopd.

**COMPLETED**



