


Map No. _____ Sec. 17 Twp. 28 R. 4
 Well No. 18 Hoskins Farm _____
Empire Company

NORTH

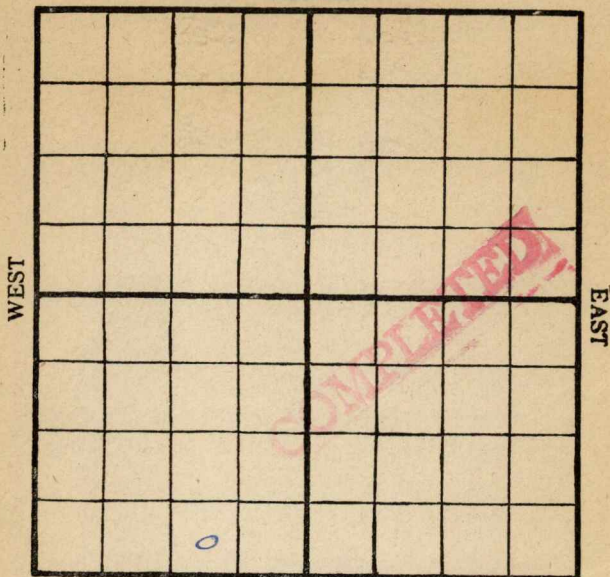

SOUTH

Location _____

Rig Up _____

Drilling Remarks:

Drilling Remarks:

RECORD

PRODUCTION

Cased _____ in. _____ ft.
 Sand _____
 Gas _____
 Oil _____
 Total Depth _____

1st 24 hrs. Nat. _____
 1st 24 hrs. after shot _____
 Gas _____ cu. ft.
 Dry Hole _____
 Abandoned _____


1002
Map No. 111 Sec. 17 Twp. 28 R. 4Well No. 18 HaskinsEngine Company

Contractor

NORTH

WEST

EAST

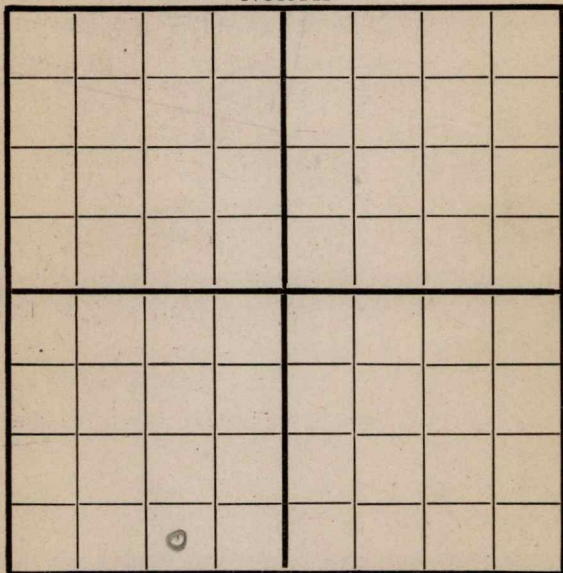

330 S-990 E SOUTH

Location _____

Rig up ☒

Drilling and Remarks:

FIRST REPORT

RECORD

Cased _____ in., _____ ft.

Sand _____

Gas _____

Oil _____

Total Depth _____

PRODUCTION

1st 24 hrs. Nat. _____

1st 24 hrs. after shot _____

Gas _____ Cu. Ft.

Dry Hole _____

Abandoned _____

Date

9/13 191 8 Condy Scout


Map No. 511 Sec. 17 Twp. 28 R. 4Well No. 18 HastingsCompany Cummins

Contractor _____

NORTH

WEST

EAST

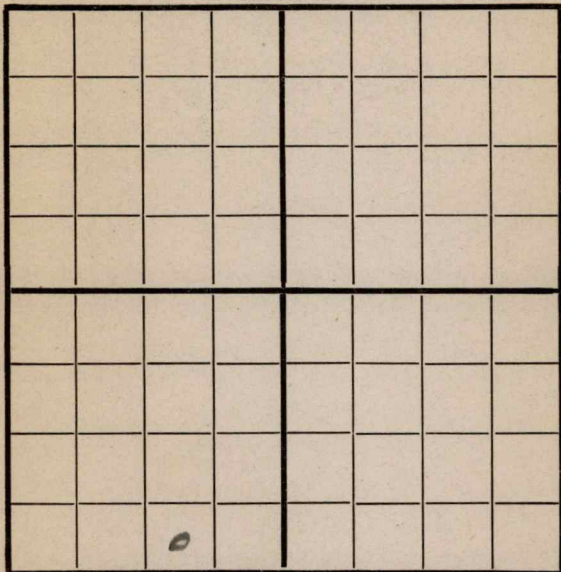

SOUTH

3305-990E

Location _____

Rig up ☒ _____

Drilling and Remarks:

RECORD

Cased _____ in., _____ ft.

Sand _____

Gas _____

Oil _____

Total Depth _____

PRODUCTION

1st 24 hrs. Nat. _____

1st 24 hrs. after shot _____

Gas _____ Cu. Ft.

Dry Hole _____

Abandoned _____

Date

9/18 1918 Cummins


Scout _____

Map No. 1511 Sec. 17 Twp. 28 R. 4Well No. 18 Huston
Engine Company
Contractor

NORTH

WEST

EAST

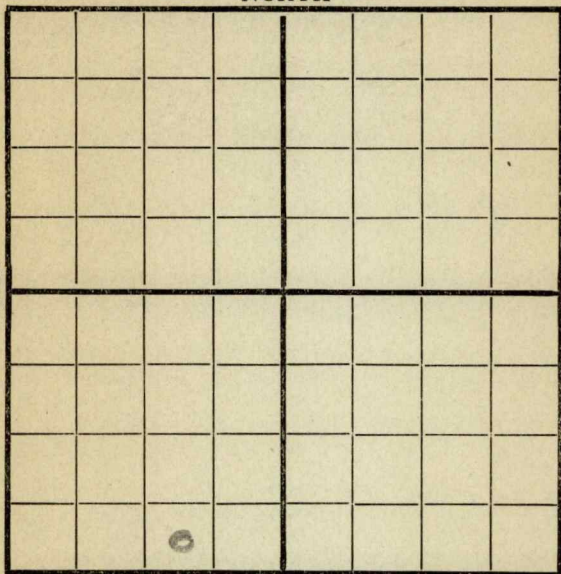

SOUTH

Location ✓Rig up ✓

Drilling and Remarks:

RECORD

Cased _____ in., _____ ft.

Sand _____

Gas _____

Oil _____

Total Depth _____

PRODUCTION

1st 24 hrs. Nat. _____

1st 24 hrs. after shot _____

Gas _____ Cu. Ft.

Dry Hole _____

Abandoned _____

Date

7/25-8 Conley Scout
191

Map No. 1511 Sec. 17 Twp. 28 R. 4Well No. 18Company EmpireContractor W. E. JohnsonAugusta NORTH Ks

WEST

EAST

SOUTH

Location ✓Rig up ✓

Drilling and Remarks:

Spudding

RECORD

Cased _____ in., _____ ft.

Sand _____

Gas _____

Oil _____

Total Depth _____

PRODUCTION

1st 24 hrs. Nat. _____

1st 24 hrs. after shot _____

Gas _____ Cu. Ft.

Dry Hole _____

Abandoned _____

Date

192 8 Conley 191 Scout


Map No. 1511 Sec. 17 Twp. 28 R. 4Well No. 18 HastingsEngine Company

Contractor

NORTH

WEST

EAST

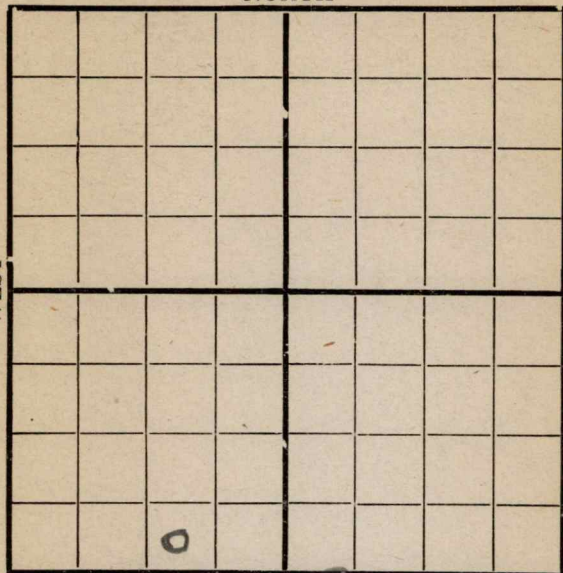

SOUTH

3305-990

Location _____

Rig up _____

Drilling and Remarks:

1335

RECORD

Cased _____ in., _____ ft.

Sand _____

Gas _____

Oil _____

Total Depth _____

PRODUCTION

1st 24 hrs. Nat. _____

1st 24 hrs. after shot _____

Gas _____ Cu. Ft.

Dry Hole _____

Abandoned _____

Date

10/16 1918 8 Chadwick Scout


Map No. K 4 Sec. 17 Twp. 28 R. 4Well No. 18 HookingCompany Empire

Contractor _____

NORTH

WEST

EAST

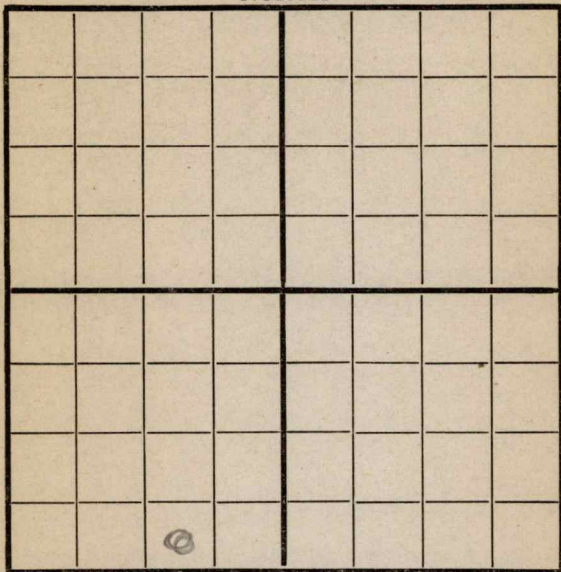

SOUTH

3302-990 E

Location _____

Rig up _____

Drilling and Remarks:

780

RECORD

Cased _____ in., _____ ft.

Sand _____

Gas _____

Oil _____

Total Depth _____

PRODUCTION

1st 24 hrs. Nat. _____

1st 24 hrs. after shot _____

Gas _____ Cu. Ft.

Dry Hole _____

Abandoned _____

Date

10/9

191

J. Conley

Scout


Map No. 1511 Sec. 17 Twp. 28 R. 4Well No. 18 HastingsEngine Company

Contractor

NORTH

WEST

EAST

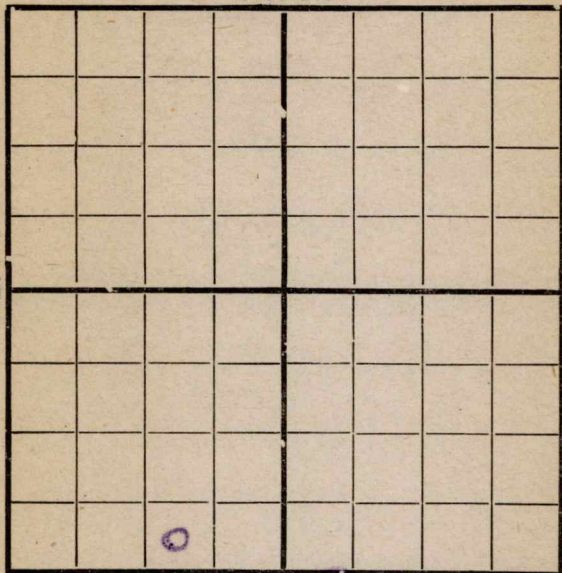

SOUTH

3305-990

Location

Rig up

Drilling and Remarks:

2220

RECORD

Cased _____ in., _____ ft.

Sand _____

Gas _____

Oil _____

Total Depth _____

PRODUCTION

1st 24 hrs. Nat. _____

1st 24 hrs. after shot _____

Gas _____ Cu. Ft.

Dry Hole _____

Abandoned _____

Date

10/23

191

8 Cuddy

Scout


Map No. 1511 Sec. 17 Twp. 28 R. 4Well No. 18 HastingsEmpire Company

Contractor

NORTH

WEST

EAST

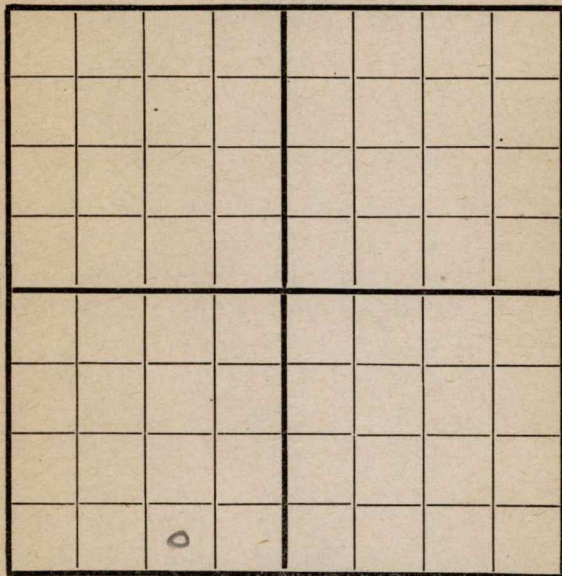

SOUTH

330 x 990 E

Location _____

Rig up _____

Drilling and Remarks:

2470

RECORD

Cased _____ in., _____ ft.

Sand _____

Gas _____

Oil _____

Total Depth _____

PRODUCTION

1st 24 hrs. Nat. _____

1st 24 hrs. after shot _____

Gas _____ Cu. Ft.

Dry Hole _____

Abandoned _____

Date

10/30 1918 J. C. Cuddy Scout


Map No. 1511 Sec. 17 Twp. 28 R. 4Well No. 18 HastingsEmpire Company

Contractor

NORTH

WEST

EAST

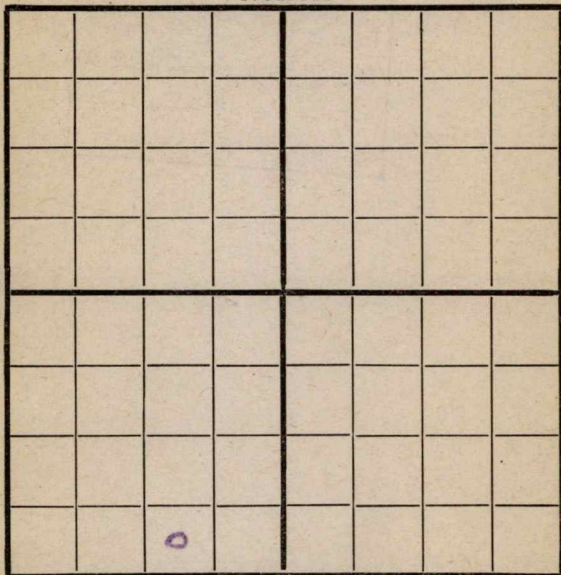

SOUTH

330 & 990 E

Location _____

Rig up _____

Drilling and Remarks:

Est at
40 Bbls

RECORD

Cased _____ in., _____ ft.

Sand 2481-2499

Gas _____

Oil _____

Total Depth _____

PRODUCTION

1st 24 hrs. Nat. _____

1st 24 hrs. after shot _____

Gas _____ Cu. Ft.

Dry Hole _____

Abandoned _____

Date

11/6191Scout

Scout