


Russell

Form 51-5M-5-84-Palace

Map No. *KANSAS* Sec. *27* Twp. *13* R. *14<sup>w</sup>*

Well No. *1 Killian* Farm  
*Tom Palmer* Company

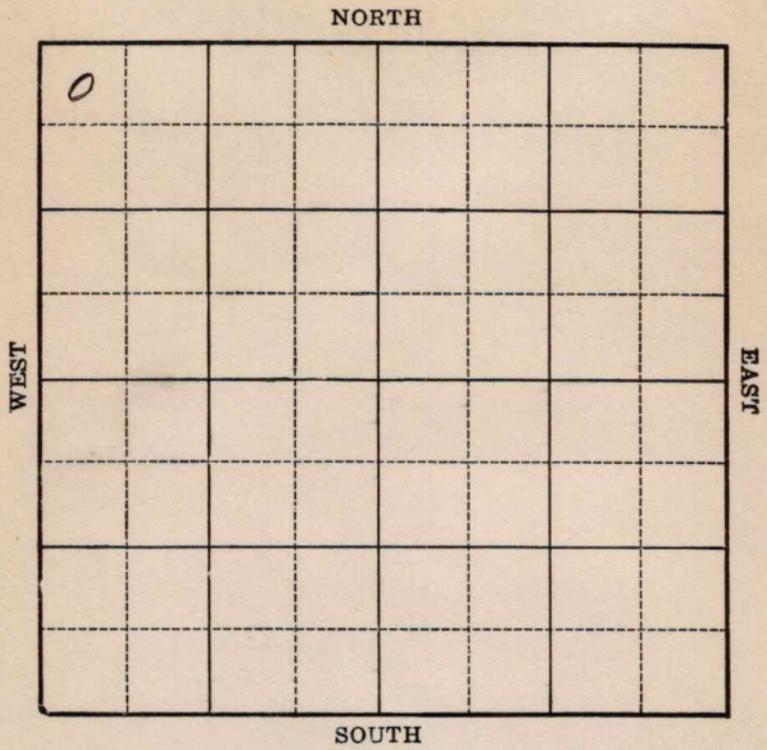

Location \_\_\_\_\_

Drilling Remarks \_\_\_\_\_

\_\_\_\_\_

\_\_\_\_\_

**RECORD**

Cased \_\_\_\_\_ in. \_\_\_\_\_ ft.

Sand \_\_\_\_\_

Gas \_\_\_\_\_

Oil \_\_\_\_\_

Total Depth \_\_\_\_\_

Rig Up \_\_\_\_\_

Drilling Remarks \_\_\_\_\_

\_\_\_\_\_

\_\_\_\_\_

**PRODUCTION**

1st 24 hrs. Nat. \_\_\_\_\_

1st 24 hrs. after shot \_\_\_\_\_

Gas \_\_\_\_\_ cu. ft.

Dry Hole \_\_\_\_\_

Abandoned \_\_\_\_\_

Russell

Map No. **KANSAS** Sec. 27 Twp. 13 R. 14<sup>W</sup>


Well No. 1 Killian Farm  
Tom Palmer. Company

330 Ft. from N. Line

\_\_\_\_\_ Ft. from S. Line

\_\_\_\_\_ Ft. from E. Line

330 Ft. from W. Line

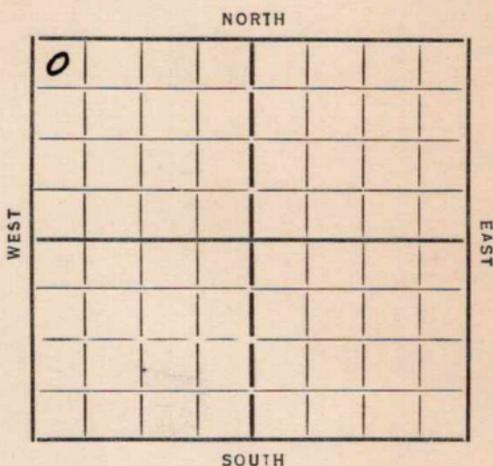

Date 1934

REPORT

9/5 Rig  
9/13 dly 530 15" 369  
9/20 " 875  
9/27 " 1785  
10/4 " 2370  
10/11 " 2880 A. H. 2375-80 10" 2450  
10/18 Orwell 3005 8 1/4 3064  
A.O. 3080 HFW 3083 dly 3110  
10/25 6" 3177 Pay 3189-94 250' oil 1 hr.  
10/31 Orwell 3005 Oil 3189-94  
T 7 3200 1000 acid  
818 Bbls.

COMPLETED

KANSAS

Map No. 72 Sec. 27 Twp. 13 R. 14W

Well No. 1-Killian

Tom Palmer Company

Contractor

FIRST REPORTS

SECTION PLAT

330 Ft. from N. Line  
\_\_\_\_ Ft. from S. Line  
\_\_\_\_ Ft. from E. Line  
330 Ft. from W. Line

0			

Location \_\_\_\_\_

Rig up \_\_\_\_\_

Drilling and Remarks:

Rig

RECORD

Cased \_\_\_\_\_ in., \_\_\_\_\_ ft.

Sand \_\_\_\_\_

Gas \_\_\_\_\_

Oil \_\_\_\_\_

Total Depth \_\_\_\_\_

PRODUCTION

1st 24 hrs. Nat. \_\_\_\_\_

1st 24 hrs. after shot \_\_\_\_\_

Gas \_\_\_\_\_ Cu. Ft.

Dry Hole \_\_\_\_\_

Abandoned \_\_\_\_\_

Date

9-5-37 19

ORVAL MANNSCHRECK

Scout

Map No. 72 Sec. 27 Twp. 13 R. 14W

Well No. 1 - Killian

Tom Palmer Company

Contractor

**COMPLETED**

**SECTION PLAT**

0			

330 Ft. from N. Line

\_\_\_\_\_ Ft. from S. Line

\_\_\_\_\_ Ft. from E. Line

330 Ft. from W. Line

Location \_\_\_\_\_

Rig up \_\_\_\_\_

Drilling and Remarks:

1000 acid

518 bbs

**RECORD**

Cased \_\_\_\_\_ in., \_\_\_\_\_ ft.

Sand Orval 3005

Gas \_\_\_\_\_

Oil 3189-94

Total Depth 3200

**PRODUCTION**

1st 24 hrs. Nat. \_\_\_\_\_

1st 24 hrs. after shot \_\_\_\_\_

Gas \_\_\_\_\_ Cu. Ft.

Dry Hole \_\_\_\_\_

Abandoned \_\_\_\_\_

Date

10-31-34 19

**ORVAL MANNSCHECK** Scout