


Russell

Form 51-5M-5-34-Palace

Map No. **KANSAS** Sec. 27 Twp. 13 R. 14W

Well No. # 2 Killian Farm
Tom Palmer. Company

NORTH

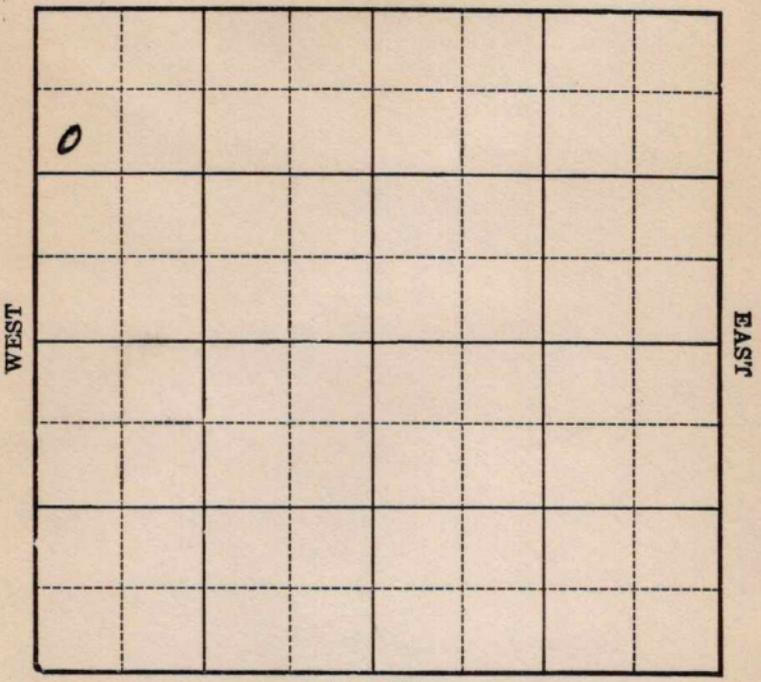

SOUTH

Location _____

Drilling Remarks _____

Rig Up _____

Drilling Remarks _____

RECORD

Cased _____ in. _____ ft.

Sand _____

Gas _____

Oil _____

Total Depth _____

PRODUCTION

1st 24 hrs. Nat. _____

1st 24 hrs. after shot _____

Gas _____ cu. ft. _____

Dry Hole _____


Abandoned _____

Russell

Map No. KANSAS Sec. 27 Twp. 13 R. 14W

Well No. 2 Killian Farm
Tom Palmer Company

1124 Ft. from N. Line
Ft. from S. Line
Ft. from E. Line
330 Ft. from W. Line

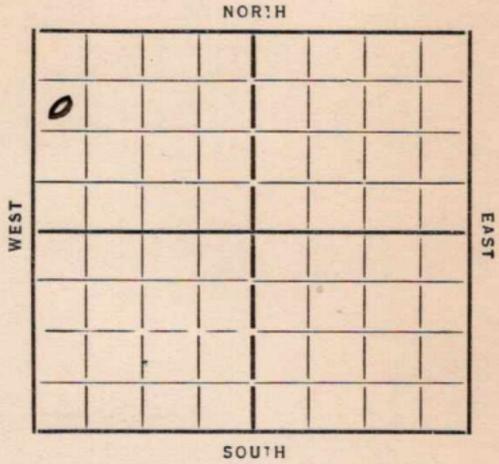

| Date | REPORT |
|------|-----------------------------------|
| 1/9 | B. R. |
| 1/17 | Spud |
| 1/24 | 5" 375 12" 2560 10" 868 |
| | Dlg 1050 |
| 1/31 | " 2105 Anky 855 |
| 2/7 | " 2705 8" 2462 |
| 2/14 | Log 2855 |
| 2/21 | |
| 2/28 | Dlg 2910 |
| 3/7 | 3088 U R 6" Overall 2998 HFW 3030 |
| 3/14 | HFW 100-06 6" 3179 Dlg 3185 |
| 3/21 | Silicious 3265 6" 3268 |
| | Pay 3268-71 2800' oil P.B.P. |
| 3/28 | 1000 acid |
| 4/3 | Silicious 3265 T-1 3271 |
| | 1000 acid 336 Bbls. |

COMPLETED

Map No. 72 Sec. 27 Twp. 13 R. 14W

Well No. 2-Killian

Tom Palmer Company

Contractor

FIRST REPORTS

SECTION PLAT

1124 Ft. from N. Line

..... Ft. from S. Line

..... Ft. from E. Line

330 Ft. from W. Line

| | | | |
|---|--|--|--|
| 0 | | | |
| | | | |
| | | | |
| | | | |
| | | | |

Location.....

Rig up.....

Drilling and Remarks:

BR

RECORD

Cased.....in.,ft.

Sand.....

Gas.....

Oil.....

Total Depth.....

PRODUCTION

1st 24 hrs. Nat.....

1st 24 hrs. after shot.....

Gas.....Cu. Ft.

Dry Hole.....

Abandoned.....

Date

1-9-35 192

ORVAL MANNSCHRECK

.....Scout

Map No. 77 Sec. 27 Twp. 13 R. 14W

Well No. 2-Killian

Tom Palmer Company

Contractor

COMPLETED

SECTION PLAT

1124 Ft. from N. Line

..... Ft. from S. Line

..... Ft. from E. Line

330 Ft. from W. Line

| | | | |
|---|--|--|--|
| 0 | | | |
| | | | |
| | | | |
| | | | |

Location.....

Rig up.....

Drilling and Remarks;

1000 acid

336 lbs

RECORD

Cased..... in., ft.

Sand silicious 3265

Gas.....

Oil.....

Total Depth 3271

PRODUCTION

1st 24 hrs. Nat.....

1st 24 hrs. after shot.....

Gas..... Cu. Ft.

Dry Hole.....

Abandoned.....

Date

4-3-35 192.....

ORVAL MANNSCHRECK

Scout