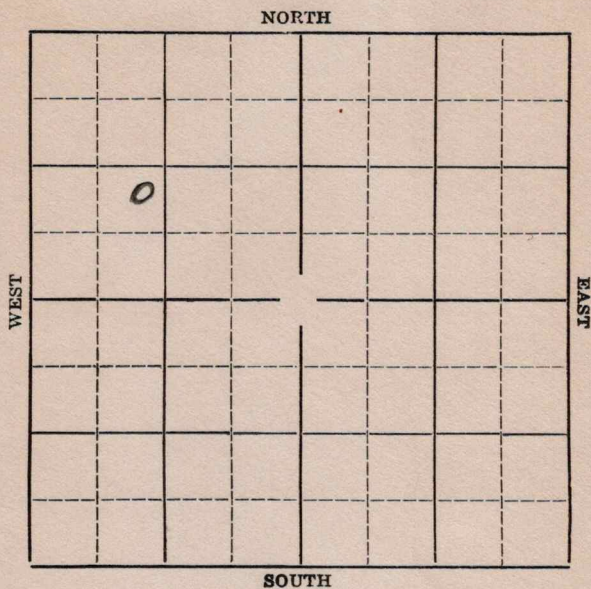


Section 27 Township 13 Range 14-WWell Number #8-KillianCompany Palmer et al

Sec. 27 Twp. 13 R. 14W


Well No. #8 Killiam Farm
Palmer et al Company

Ft. from N. Line

908' Ft. from S. Line

_____ Ft. from E. Line

1188' Ft. from W. Line

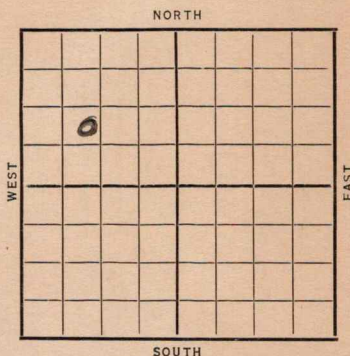[illegible]

KANSAS

Map No. 72 Sec. 27 Twp. 13 R. 14W

Well No. 8 Killian

Palmer & Co. Company

Contractor

SECTION PLAT

0			

 Ft. from N. Line

908 Ft. from S. Line

 Ft. from E. Line

1188 Ft. from W. Line

FIRST REPORT

Location

Rig up

Drilling and Remarks:

Dry 305

RECORD

Cased in., ft.

Sand

Gas

Oil

Total Depth

PRODUCTION

1st 24 hrs. Nat.

1st 24 hrs. after shot

Gas Cu. Ft.

Dry Hole

Abandoned

Date

AUG 19 1936 19

S. J. LEWIS

Scout

Map No. 72 Sec. 27 Twp. 13 R. 14W

Well No. 8 Killian

Palmer & Gal. Company

Contractor

SECTION PLAT

0			

 Ft. from N. Line

908 Ft. from S. Line

 Ft. from E. Line

1188 Ft. from W. Line

COMPLETED

RECORD

Location

Cased in., ft.

Rig up

Sand

Drilling and Remarks:

Gas

Oil 3269

Oil

Total Depth 3270

PRODUCTION

1st 24 hrs. Nat.

1st 24 hrs. after shot

Gas Cu. Ft.

Dry Hole

Abandoned

Ps 8277

Date

NOV 4 1936 19

S. J. LEWIS Scout