

Butler


FORM 51 IOM 12-46 PETROL

KANSAS

Section 17 Township 28 Range 4E

Well No. 22 Haskins

Company Cities Service

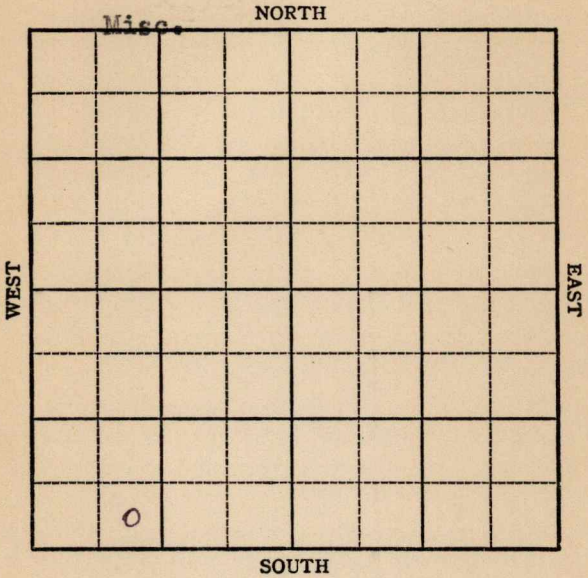

KANSAS

Butler

✓

Sec. 17 Twp. 28 R. 4E

Well No. #22 Haskins Farm

Cities Service Company

Miscellaneous


 Ft. from N. Line

330 Ft. from S. Line

 Ft. from E. Line

990 Ft. from W. Line

SE SW SW

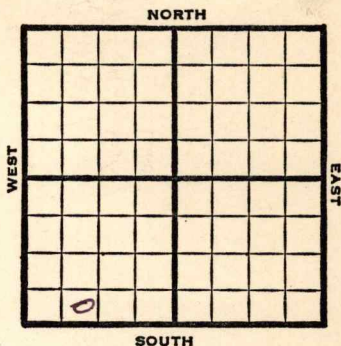

1947

Elev. 1221'

REPORT

8/27

Location

9/3

Drlg. 55'

9/10

"

9/17

Lansing 1685'

KC 2222'

Drlg. 2365'

9/24

Arb. 2463'

7" @ 2464'

Pump 37 Pot

38.0 Gr.

TD 2475'

COMPLETED

Map No. _____ Sec. 17 Twp. 28 R. 4E

Well No. 22 Haskins

Cities Service Company

FIRST REPORT Contractor

SE SW SW

SECTION PLAT

_____ Ft. from N. Line

330 Ft. from S. Line

_____ Ft. from E. Line

990 Ft. from W. Line

Butler County

Location X

Rig up _____

Drilling and Remarks:

RECORD

Cased _____ in., _____ ft.

Sand _____

Gas _____

Oil _____

Total Depth _____

PRODUCTION

1st 24 hrs. Nat. _____

1st 24 hrs. after shot _____

Gas _____ Cu. Ft.

Dry Hole _____

Abandoned _____

Date

AUG 27 1947 19

S. J. LEWIS

Scout

Map No. 11 Sec. 17 Twp. 28 R. 4E

Well No. 22 Haskins

Cities Service


Company

COMPLETE

Contractor

SE SW SW

E. 1221
SECTION PLAT

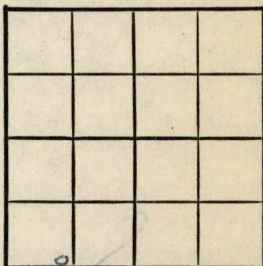

Ft. from N. Line

330 Ft. from S. Line

Ft. from E. Line

990 Ft. from W. Line

Butler County

Location

Rig up

Drilling and Remarks:

CR 2468

7" @ 2464

July 27 58

38° 34'

RECORD

Cased in., ft.

Sand

Gas

Oil

Total Depth 2475

PRODUCTION

1st 24 hrs. Nat.

1st 24 hrs. after shot

Gas Cu. Ft.

Dry Hole

Abandoned

Date

SEP 24 1947 19

S. L. LEWIS

Scout