


SECTION 17 TOWNSHIP 28S RANGE 4E

WELL NO. #1-Haskins "A"

COMPANY H & M Drlg.

SE SE NW

NORTH

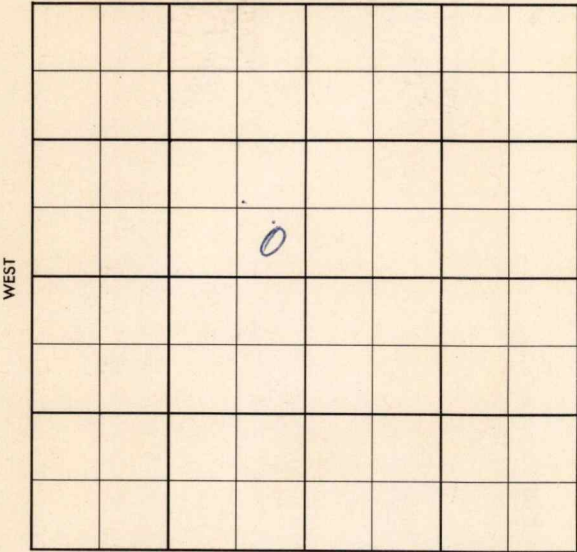

SOUTH

County Butler Elev. 1210
 Sec. 17 Twp. 28 Rgs. 4E
 Company H & M Drlg.
 Farm Name Haskins "A" No. 1

Co.

TOPS	DEPTH	LOG	DATUM	Loc. in Sec.																
Anh.				SE SE NW																
Tp.																				
H.				2550' NL																
Tr.																				
Dg.				2400' WL																
Bl.																				
L.				Geol.																
K.C.				Contr.																
B.K.C.																				
Ce.				Co. tools																
C.																				
M.				Pool																
M.				Augusta																
K.																				
Mz.																				
Me.																				
V.																				
S.																				
S.																				
A	2375			<table border="1"> <tr> <td colspan="4">ABANDONED</td> </tr> <tr> <td></td> <td></td> <td></td> <td></td> </tr> <tr> <td></td> <td></td> <td></td> <td></td> </tr> <tr> <td></td> <td></td> <td></td> <td></td> </tr> </table>	ABANDONED															
ABANDONED																				
R.																				
Pe.																				
G.																				
T.D.	2432			<table border="1"> <tr> <td></td> <td></td> <td></td> <td></td> </tr> <tr> <td></td> <td></td> <td></td> <td></td> </tr> <tr> <td></td> <td></td> <td></td> <td></td> </tr> <tr> <td></td> <td></td> <td></td> <td></td> </tr> </table>																

Loc.

No.

Sec.

T.

R.

Date Comm.

Location Jul 17 '57 Surf set Jul 24 '57

Aug 31 '57 878 85/75 7-25-57

Ø 2120 AUG 9 '57 crd 2378-2408

5 1/2 2432 8/2376-78 fst 6

Goph AUG 14 '57 1/4 Hole Full wt

sq 24/2385-92 1/4 Hole

Full wt

D & A

County Butler Elev. 1210
 Sec. 17 Twp. 28 Rge. 4E
 Company H & M Drlg.
 FarmName Haskins "A" No. 1

TOPS	DEPTH	LOG	DATUM	Loc. in Sec.
Anh.				SE SE NW
Tr.				2550' NL
H.				2400' WL
Tr.				
Dg.				
Bl.				
L.				Geol.
K.C.				Contr.
B.K.C.				Co. tools
Ce.				Pool
C.				Augusta
M.				<div style="border: 1px dashed black; padding: 5px; text-align: center;"> <p>FIRST REPORT</p> <p>JUL 10 1957</p> </div>
M.				
K.				
Mz.				
Me.				
V.				
S.				
S.				
A				
R.				
PE.				
G.				
T.D.				

Date Comm.

Location

~~29~~