


Map No. _____ Sec. 12 Twp. 28 R. 4
 Well No. 3 ~~Berkland~~ Farm _____
 _____ Empire Company

NORTH

WEST

EAST

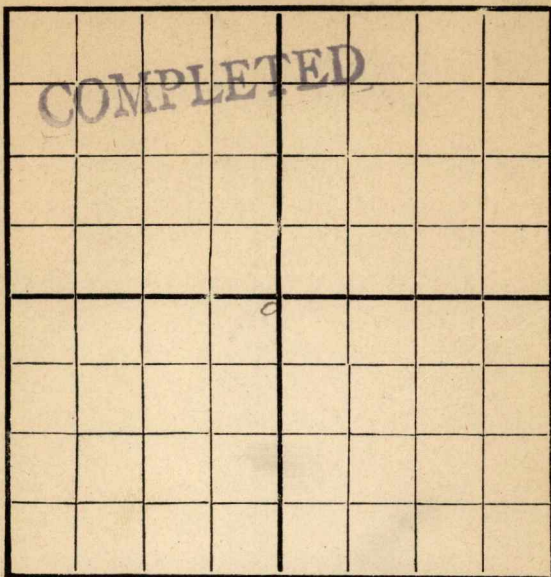

SOUTH

Location _____

Rig Up _____

Drilling Remarks:

Drilling Remarks:

RECORD

PRODUCTION

Cased _____ in _____ Ft.

1st 24 hrs. Nat _____

Sand _____

1st 24 hrs. after shot _____

Gas _____

Gas _____ Cu. Ft.

Oil _____

Dry Hole _____

Total Depth _____


Abandoned _____

Map No. _____ Sec. 17 Twp. 28 R. 4
 Well No. 3 Kirkland Farm _____
Engine Company _____

NORTH

WEST

EAST

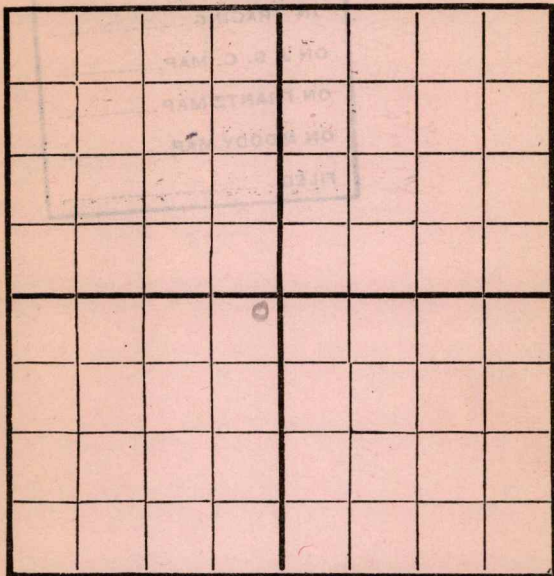

SOUTH

Location _____

Rig Up _____

Drilling and remarks

RECORD

Cased _____ in. _____ Ft.

Sand _____

Gas _____

Oil _____

Total Depth _____

PRODUCTION

1st 24 hrs. Nat. _____

1st 24 hrs. after shot _____

Gas _____ Cu. Ft.

Dry Hole _____

Abandoned _____

Rigging
FIRST REPORT

Date


5/25, 1912 C. C. C. Scout

Map No. _____ Sec. 17 Twp. 28 R. 4
 Well No. 3 Kirkpatrick Farm _____
Engle Company _____

NORTH

WEST

EAST

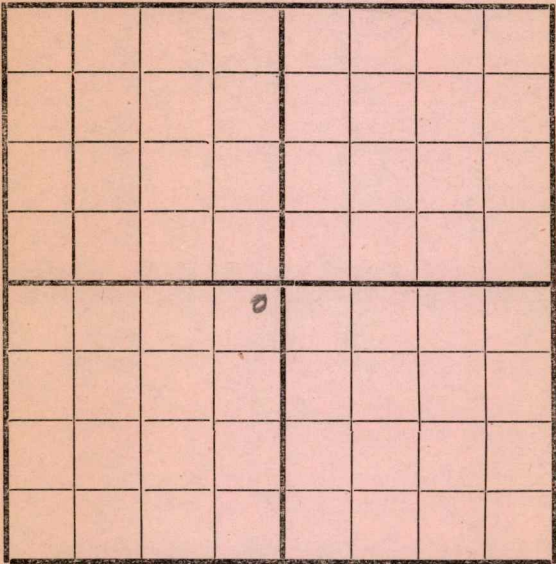

SOUTH

Location _____
 Rig Up _____
 Drilling and remarks
Rigged up

RECORD

Cased _____ in. _____ Ft.
 Sand _____
 Gas _____
 Oil _____
 Total Depth _____

PRODUCTION

1st 24 hrs. Nat. _____
 1st 24 hrs. after shot _____
 Gas _____ Cu. Ft.
 Dry Hole _____
 Abandoned _____


Date 5/29, 1917 Cordell Scout

Map No. _____ Sec. 17 Twp. 28 R. 4
 Well No. 3 Kirkpatrick Farm
Empire Company

NORTH

WEST

EAST

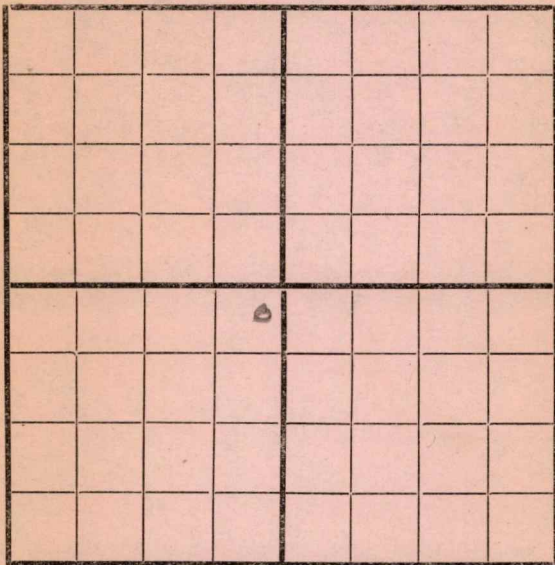

SOUTH

Location _____
 Rig Up _____
 Drilling and remarks

Rigged up

RECORD


Cased _____ in. _____ Ft.
 Sand _____
 Gas _____
 Oil _____
 Total Depth _____

PRODUCTION

1st 24 hrs. Nat. _____
 1st 24 hrs. after shot _____
 Gas _____ Cu. Ft.
 Dry Hole _____
 Abandoned _____

Date 6/8, 1917 C. Carby Scout

Map No. _____ Sec. 17 Twp. 28 R. 4
 Well No. 3 Kirkpatrick Farm
Carroll Company
 NORTH

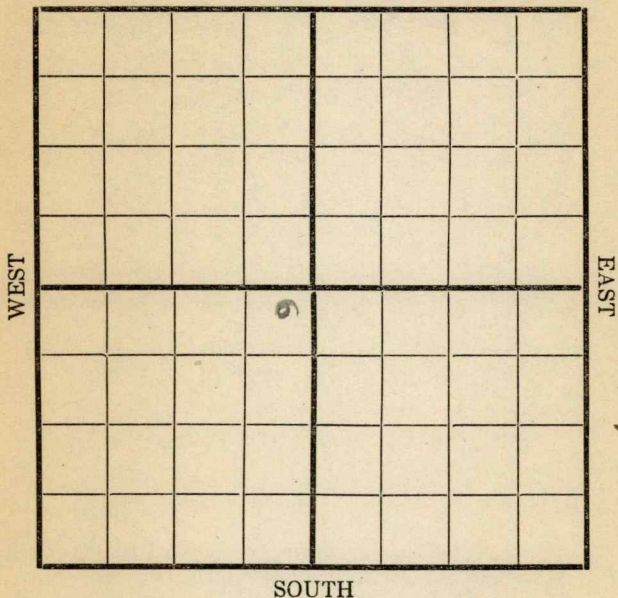

SOUTH

Location _____
 Rig Up _____
 Drilling and remarks

1050

RECORD

Cased _____ in. _____ Ft.
 Sand _____
 Gas _____
 Oil _____
 Total Depth _____

PRODUCTION


1st 24 hrs. Nat. _____
 1st 24 hrs. after shot _____
 Gas _____ Cu. Ft.
 Dry Hole _____
 Abandoned _____

Date

6/12, 191 7 Carroll Scout

Map No. _____ Sec. 17 Twp. 28 R. 4
 Well No. 3 Kinkpatrick Farm _____
Empire Company _____

NORTH

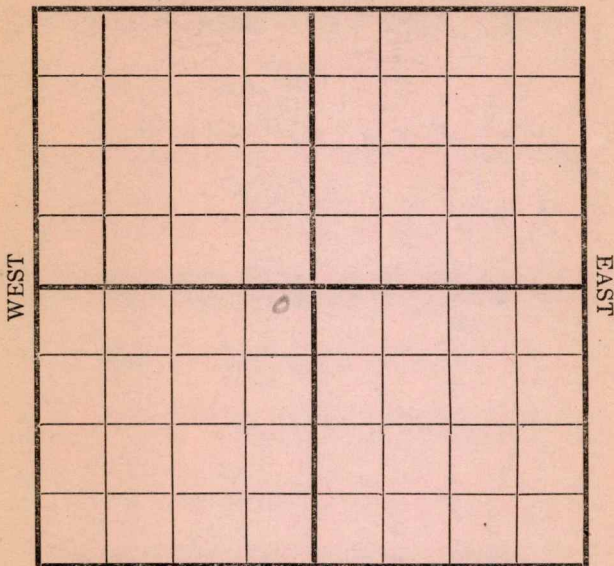

SOUTH

Location _____
 Rig Up _____
 Drilling and remarks _____

1385'

RECORD

Cased _____ in. _____ Ft.
 Sand _____
 Gas _____
 Oil _____
 Total Depth _____


PRODUCTION

1st 24 hrs. Nat. _____
 1st 24 hrs. after shot _____
 Gas _____ Cu. Ft.
 Dry Hole _____
 Abandoned _____

Date 6/20, 1917 C. C. C. C. Scout

Map No. _____ Sec. 17 Twp. 28 R. 4
 Well No. 3 Kippmire Farm
Empire Company

NORTH

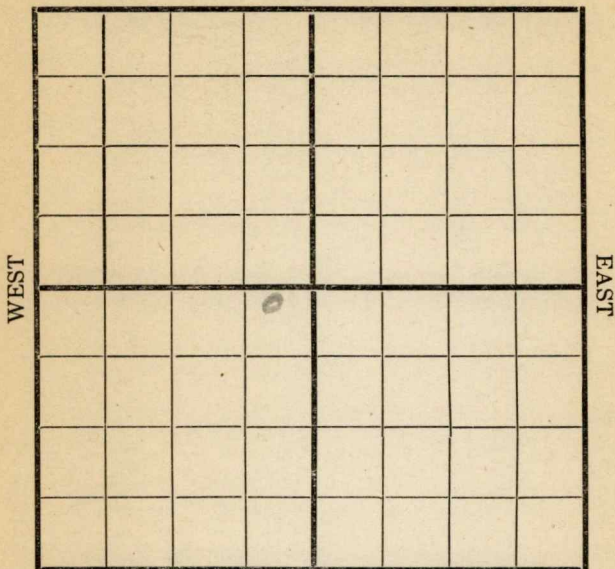

SOUTH

Location _____

Rig Up _____

Drilling and remarks

1350

RECORD

Cased _____ in. _____ Ft.

Sand _____

Gas _____

Oil _____

Total Depth _____

PRODUCTION

1st 24 hrs. Nat. _____

1st 24 hrs. after shot _____

Gas _____ Cu. Ft.

Dry Hole _____

Abandoned _____

Date

6/27 191 2 Empire Scout

Map No. _____ Sec. 17 Twp. 28 R. 4
 Well No. 3 Kirkpatrick Farm _____
Engine Company _____

NORTH

COMPLETED

SOUTH

Location _____
 Rig Up _____
 Drilling and remarks _____

Est. at
125 Bbls

RECORD

Cased _____ in. _____ Ft.
 Sand 1918-1940
 Gas _____
 Oil _____
 Total Depth _____

PRODUCTION

1st 24 hrs. Nat. _____
 1st 24 hrs. after shot _____
 Gas _____ Cu. Ft.
 Dry Hole _____
 Abandoned _____

Date

7/6, 1917 Cordell Scout