


Russell

KANSAS

Section 27 Township 13 Range 14W

Well No. #1 Mingenback

Company Stearns Petroleum Company

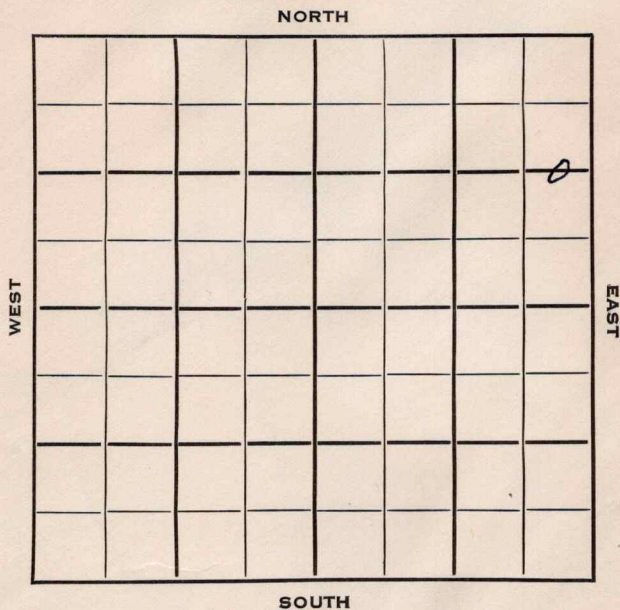



Sec. 27 Twp. 13 R. 14 W

Well No. # 1 Mingenback Farm

Stearns Pet. Company

Contractor


1320 Ft. from N. Line

_____ Ft. from S. Line

330 Ft. from E. Line

_____ Ft. from W. Line

C E/2 E/2 NE

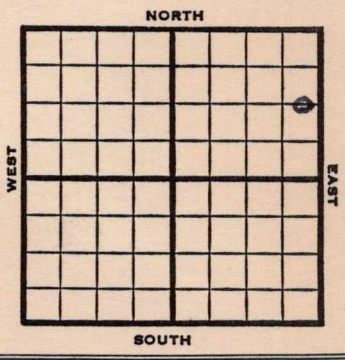

1953

Elev. 183 1/4'

REPORT

3/11

Location

3/19

"

3/26

"

4/2

"

4/9

"

4/16

8" @ 223

Drlg. 1616'

4/23

TD 3259

5" @ 3259

4/30

Heeb 2926, Lans 2982, Arb. 3257

5/6

Spud 4-9-53 Oil well TD 3267

8" @ 223

Heeb 2926

Lans 2982

Arb. 3257'

TD 3259

DD 3267

5" @ 3259 6 BOPH

Comp. 50 BOPD

COMPLETED

County Russell State Kansas

Sec. 27 (Blk. Twp.) 13 (Sur. Rge.) 14W Map No.

Operator Stearns Pet.

Well No. 1 Farm Mingenback

Elev. _____ Location C E $\frac{1}{2}$ E $\frac{1}{2}$ NE

1320 Ft. From N Line NE

330 Ft. From E Line Quarter

1st. Report MAR 11 1953

Completion _____

Remarks _____

Spudding Date _____

Drlg. Data _____

Location _____

