


Section 27 Township 13 Range 14W

Well No. 1 - Mohl

Company Shields Oil

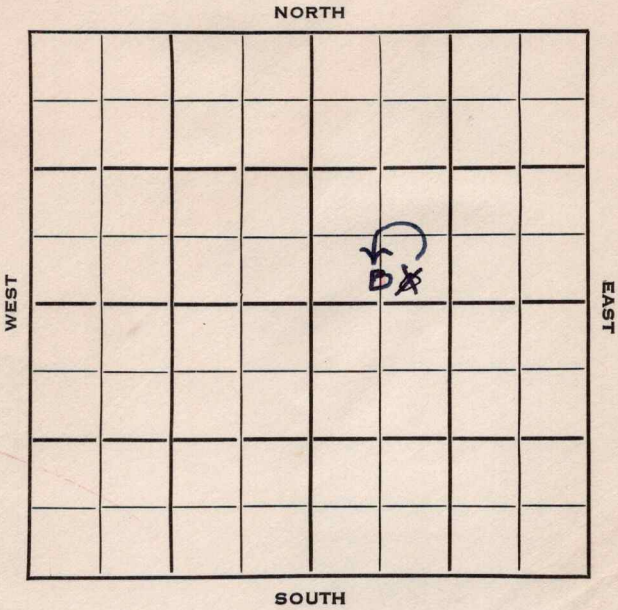

Russell **KANSAS** ✓Sec. 27 Twp. 13 R. 14WWell No. #1 Mohl FarmShields Oil CompanyShields Contractor


Ft. from N. Line

NORTH

Ft. from S. Line

Ft. from E. Line

Ft. from W. Line

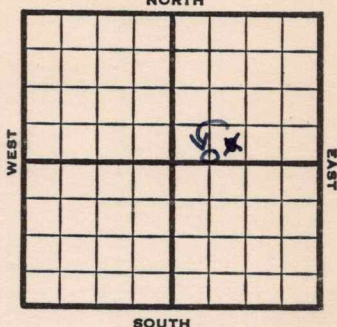~~SE SW NE~~~~C SL SW NE~~1952 **Elev. 1835'** REPORT12/23 Spud 12-18-52
Drlg. 2000'

12/25 " " "

1/1 Drlg. 2400

1/8 8" @ 145 Tarkio 2379 Top 2704 Heeb
2932 Tor 2950 Lans 2989 Arb 3262
RTD 3266 5" @ 3264

1/22 NR

1 28 Spud 12-18-52
Oil Well
Td 3277
8" @ 145**Tarkio 2379, Top 2704, Heeb
2932, Tor 2950, Lans 2989, Arb.
3262**

TD 3266

5" @ 3264

DD 3273 500A S/4 boph DD ~~XX~~
3277, 500A, S/ 5 boph
Comp. 50 bopd**COMPLETED**

County	Russell		State	Kansas
Sec.	27	(Blk.) (Twp.) 13	(Sur.) (Rge.) 14W	Map No.

Sec. **27** (Blk.) **13** (Sur.) **1 4W** Map No.

Operator Shields Oil

Well No. 1 Farm Mohl

Elev.	Location	SE	SW	NE
-------	----------	----	----	----

330 Ft. From S Line NE

990 Ft. From W Line Quarter

1st. Report DEC 23 1952

Completion

Remarks

Shields - Contr.

Spudding Date 12-18-52

Drlg. Data

drlg. 2000

J. G. McGEHEE

County Russell State Kansas

Sec. 27 (Blk. Twp.) 13 (Sur. Rge.) 14W Map No.

Operator Shields Oil

Well No. 1 Farm Mohl

Elev.	1835	Location	SE SW NE
-------	------	----------	----------

330 Ft. From S Line NE

990 Ft. From W Line Quarter

1st. Report

Completion JAN 28 1953

Remarks

Shields - Contr.

Spudding Date 12-18-52

Drig. Data Oil well TD 3277

8" @ 145 Tarkio 2379 Top. 2704

Heeb. 2932 Tor. 2950 Lans. 2989

Arb. 3262 TD 3266 5" @ 3264 DD 3273

500 A S/ 4 boph DD 3277 500 A

S/ 5 boph Comp. 50 bopd

Map No. _____ Sec. 27 Twp. 13 R. 14WWell No. 1 Mohl

Shields Oil _____ Company

CORRECTION

Contractor _____

C S L SW NE

SECTION PLAT

		o	

_____ Ft. from N. Line

130 Ft. from S. Line

_____ Ft. from E. Line

640 Ft. from W. Line

Russell County

Location _____

Rig up _____

Drilling and Remarks:

Completed

1-28-53

SE SW NE

RECORD

Cased _____ in., _____ ft.

Sand _____

Gas _____

Oil _____

Total Depth _____

PRODUCTION

1st 24 hrs. Nat. _____

1st 24 hrs. after shot _____

Gas _____ Cu. Ft.

Dry Hole _____

Abandoned _____

Date

APR 8 1953 19

J. G. McGEHEE Scout