

Russell

FORM 51


KANSAS

Section 27 Township 13 Range 11W

Well No. 1 Schaffer 2 Mohl Schaffer

Company Shields Oil

NORTH

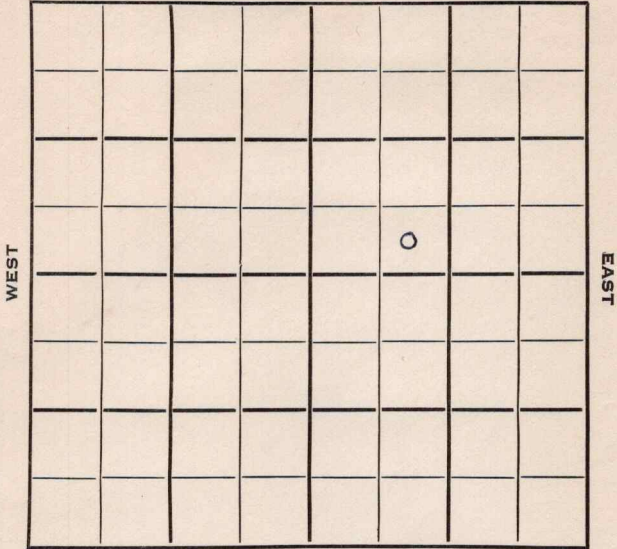

SOUTH

Sec. 27 Twp. 13 R. 14 W

2 Mohl-Schaffer
~~# 1 Schaffer~~

Well No. Farm

Shields Oil Company

Contractor


Ft. from N. Line

330 Ft. from S. Line

Ft. from E. Line

990 Ft. from W. Line

SE SW NE

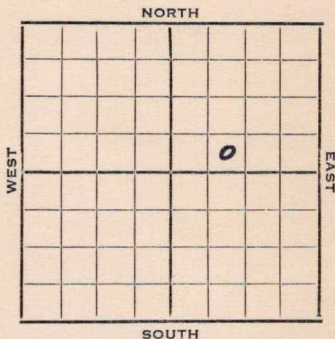

1953

Elev. 1837' REPORT

4/1

Location

4/9

"

4/16

"

4/23

"

4/30

8" @ 145
Drlg. 1250'

5/7

Tarkio 2380 Top 2706 Heeb 2924
Tor 2952' Lans 2993' Arb. 3266

RTD 3267 5" @ 3266

5/20

Spud 4-25-53 D & A TD 3305
8" @ 145 Tarkio 2380 Top 2706
Heeb 2924 Tor. 2952 Lans 2993
Arb. 3266 TD 3267 5" @ 3266
DD 3305 1 BSWPH PB 3200
12/3178-80 18/3167-72 30/3153-57
2000 A PB 3050 21/3030-38
18/3019-23 18/3013-17 1000 A
S/5 BFPH D & A

ABANDONED

731144

We already show oil well here

Advise

Sam

show oil well
here

APR 10 1953

~~mm~~
~~11~~

- Scout Cards
- Land Small Map
- Land Wall Map (35)
- Tracings
- France Map
- Pierce Map
- Misc.

Kansas

Map No. _____ Sec. 27 Twp. 13 R. 14W

Well No. 2 Mohl - Schaffer

Shields Oil Company

CORRECTION Contractor

SE SW NE

SECTION PLAT

_____ Ft. from N. Line

330 Ft. from S. Line

_____ Ft. from E. Line

990 Ft. from W. Line

| | | | |
|--|--|---|--|
| | | | |
| | | | |
| | | 0 | |
| | | | |
| | | | |

Russell County

Location _____

Rig up _____

Drilling and Remarks:

Reported
#1 Schaffer

RECORD

Cased _____ in., _____ ft.

Sand _____

Gas _____

Oil _____

Total Depth _____

PRODUCTION

1st 24 hrs. Nat. _____

1st 24 hrs. after shot _____

Gas _____ Cu. Ft.

Dry Hole _____

Abandoned _____

Date

APR 29 1953 19

J. G. McGEHEE Scout

