
FORM 51 IOM 12-46 PETRO KANSAS Ellis

Section 5 Township 14 Range 19W

Well No. 1 Riedel "B"

Company Stanolind

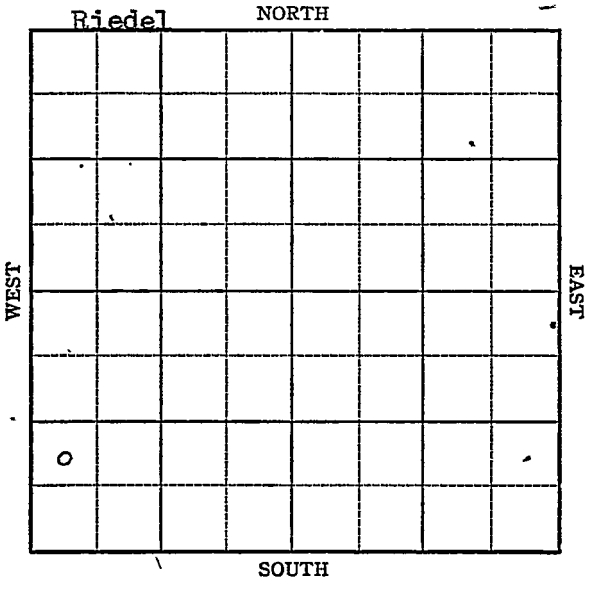

FORM 252-A
5M 12-46 PETROL

Ellis KANSAS

Sec. 5 Twp. 14 R. 19W

Well No. #1 Riedel "B" Farm

Stanolind Company
Riedel


____ Ft. from N. Line

990 Ft. from S. Line

____ Ft. from E. Line

~~330~~
~~990~~ Ft. from W. Line

NE SW SW

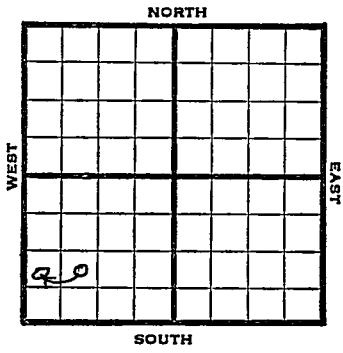

1947	REPORT Elev. 2227
4/2	Anhy 1498' Drlg. 2435'.
4/9	Lans 3499 Drlg 3554'
4/15	Arbuckle 3848' TD 3853' Run csg.
4/23	5" @ 3844' RUST
4/29	5" @ 3847' 5 qts. 3847-53 Swb 2 bbls. oil P H 6 hrs.
5/7	Arb 3848 5" @ 3847' Pump 25 Pot Grav. 28 TD 3853'

COMPLETED

Form 26-200 Bks. 10-46 Petrol

Riedel Pool

Kansas

Map No. A 72 Sec. 5 Twp. 14 R. 19W

Well No. 1 Riedel "B"


Stanolind Company

CORRECTION

Contractor

NW SW SW

SECTION PLAT

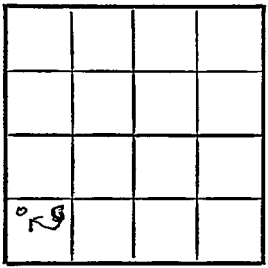

____ Ft. from N. Line

990 Ft. from S. Line

____ Ft. from E. Line

330 Ft. from W. Line

Ellis County

Location

Rig up

Drilling and Remarks:

Had spotted
NE SW SW

RECORD

Cased ____ in., ____ ft.

Sand

Gas

Oil

Total Depth

PRODUCTION

1st 24 hrs. Nat.

1st 24 hrs. after shot

Gas ____ Cu. Ft.

Dry Hole

Abandoned

Date

APR 2 1947 19

S. J. LEWIS Scout

Form 26—200 Bks. 10-45 Petrol

Kansas

Riedel Pool

Map No. _____ Sec. 5 Twp. 14 R. 19W


Well No. 1 Riedel "B"

Stanolind Company

FIRST REPORT Contractor

[redacted]

SECTION PLAT

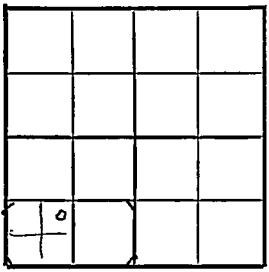

_____ Ft. from N. Line

990 Ft. from S. Line

_____ Ft. from E. Line

990 Ft. from W. Line

Ellis County

Location _____

Rig up _____

Drilling and Remarks:

anhy 1498
drlg. 2435

RECORD

Cased _____ in., _____ ft.

Sand _____

Gas _____

Oil _____

Total Depth _____

PRODUCTION

1st 24 hrs. Nat. _____

1st 24 hrs. after shot _____

Gas _____ Cu. Ft.

Dry Hole _____

Abandoned _____

Date

APR 2 1947 19

S. J. LEWIS Scout

Form 26 200 Bks. 10-46 Petrol KANSAS Riedel Pool
Kansas

Map No. K 70 Sec. 5 Twp. 14 R. 19W

Well No. 1 Riedel "B"


Stanolind Company

COMPLETE Contractor

NW SW SW

E 1/2 2 2 2 9

SECTION PLAT

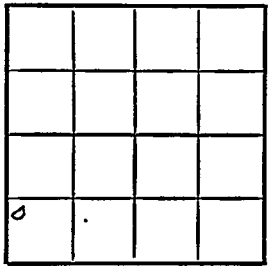

____ Ft. from N. Line

990 Ft. from S. Line

____ Ft. from E. Line

330 Ft. from W. Line

Ellis County

Location

Rig up

Drilling and Remarks:

Cer @ 3848

5" @ 3847

Pump 250 BX

28° Gr

RECORD

Cased ____ in., ____ ft.

Sand

Gas

Oil

Total Depth 3853

PRODUCTION

1st 24 hrs. Nat.

1st 24 hrs. after shot

Gas ____ Cu. Ft.

Dry Hole

Abandoned

Date

MAY 7 1947 19

S. J. LEWIS Scout