

KANSAS

O.W.P.B.

FORM 51 5M 6-46 PETROL

Ellis county

Section 6 Township 14 Range 19-W

Well No. #1, E. Irbin

Company Stanolind Oil and Gas Company

NORTH

							0

SOUTH

WEST

EAST

KANSAS O.W.P. Bellis



Sec. 6 Twp. 14 R. 19W

Well No. 1 E. Irbin Farm

Stanolind Company

Wildcat


Ft. from N. Line

330 Ft. from S. Line

330 Ft. from E. Line

Ft. from W. Line

SE/C

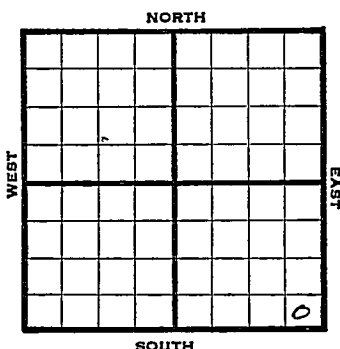

1946	Elev. 2240	REPORT
11/20	RUR	
11/27	13" @ 153'	
	Anhy. 1206'	
	Drlg 2410'	
12/3	Lans 3505'	
	Drlg 3550'	
12/10	Arb 3852-60 TD Sat	
12/17	5" @ 3853, WOC	
1947		
1/4	500 acid 18 gals oil PH TD3874'	
	1000 acid, swb 15 oil PH 3 hrs	
1/8	Swb 11 fluid PH 12 hrs 1875' off bottom 7% W	
1/15	" " "	
1/21	" " "	
COMPLETED		
OVER		


Map No. 70 Sec. 6 Twp. 14 R. 19W

Well No. 1 E. Irbin

Stanolind Company
COMPLETE

SE/C

E/12240
SECTION PLAT

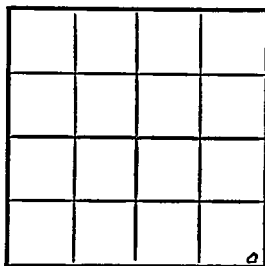

 Ft. from N. Line

330 Ft. from S. Line

330 Ft. from E. Line

 Ft. from W. Line

Ellis County

Location

Rig up

Drilling and Remarks:

Per 83852.

5" C 3853

1000 acid

*Pump 142 oil +
42 1/2 W 28*

87° 42'

RECORD

Cased in., ft.

Sand

Gas

Oil

Total Depth 3874

PRODUCTION

1st 24 hrs. Nat.

1st 24 hrs. after shot

Gas Cu. Ft.

Dry Hole

Abandoned

Date

FEB 5 1947 19

S. J. LEWIS Scout

Map No. 70 Sec. 6 Twp. 14 R. 19W

Well No. 1 E. Irbin


Stanolind Company

FIRST REPORT

Contractor

SE/C

SECTION PLAT

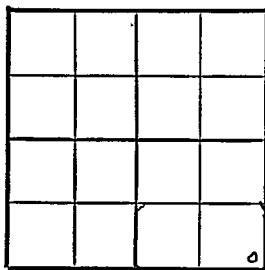

 Ft. from N. Line

330 Ft. from S. Line

330 Ft. from E. Line

 Ft. from W. Line

Ellis County

Location

Rig up

Drilling and Remarks:

R U R

RECORD

Cased in., ft.

Sand

Gas

Oil

Total Depth

PRODUCTION

1st 24 hrs. Nat.

1st 24 hrs. after shot

Gas Cu. Ft.

Dry Hole


Abandoned

Date

NOV 20 1946 19 S. J. LEWIS Scout

O.W.P.B.

County Ellis State Kansas
 Sec. 6 (Blk.) 14 (Sur.) 19W Map No.
 Operator Stanolind
 Well No. 1 Farm L. Irvin
 Elev. 2240 Location SE SE SE

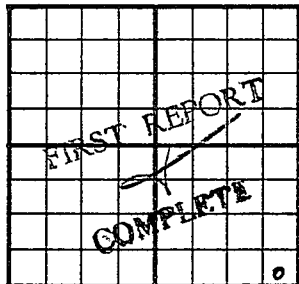

330 Ft. From S Line SE
330 Ft. From E Line Quarter
 1st. Report MAR 11 1953
 Completion MAR 11 1953
 Remarks OWPB
O.W.P.B.
 Spudding Date _____

Drig. Data Oil well TD 3874 Irvin Pool
Lens. 3526 Arb. 3853 OTD 3874
5" @ 3853 PB 3766 47/ 3553-61
P/ 121 bo 12 bwpd 1000 A
Comp. 132 bopd 30 bw

J. G. McGEHEE

2/5

TD 3874

Arb 3852

5" @ 3853

1000 Acid

Pump 142 oil T 42% W Pot

37 Grav.

COMPLETED

O. W. P. B.

1953

3/11

Oil Well TD 3874 Irvin Pool

Lans. 3526 Arb. 3858 OTD 3874

5" @ 3853 PB 3766 47/3553-61

P/121 BO 12 BWPD 1000A

Comp. 132 BOPD 30 Bw

FIRST REPORT


COMPLETED