
FORM 51 25M 8-50 WESTERN Ellis [redacted]

Section 6 Township 14 Range 19W

Well No. #2 Irvin

Company Brunson Drlg.

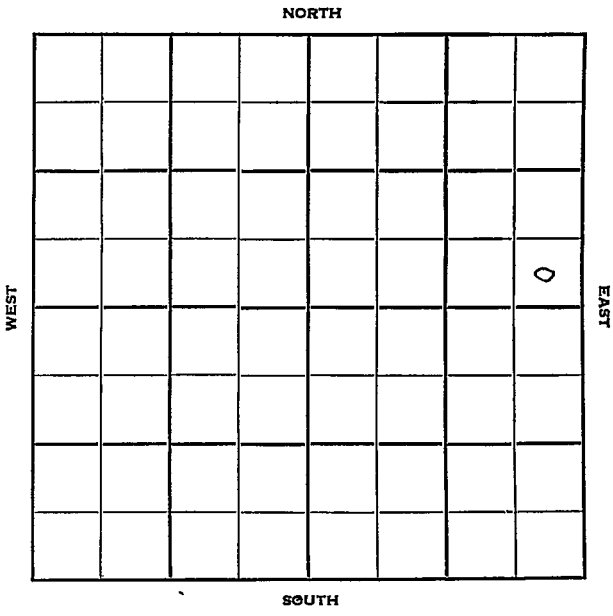

FORM 252-B
10M 8-51 TPCO.

Ellis KANSAS ✓

Sec. 6 Twp. 14 R. 19 W

Well No. # 2 Irvin Farm

Brunson Drlg. Company

Brunson Drlg. Contractor

Irvin Pool


Ft. from N. Line

330 Ft. from S. Line

330 Ft. from E. Line

Ft. from W. Line

SE SE NE

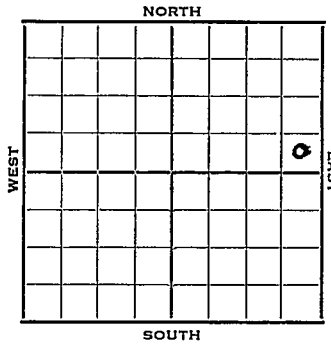

1952	Elev. 2255' REPORT
6/11	Cellar & Pits
6/18	8" @ 183 Anhy 1539' Drlg. 3010'
6/25	Heeb 3502' Lans. 3546' Simp. 3886-91' RTD 5" @ 3888' WOC
7/2	CO 3891 3/4 BOPH Hyd.
7/9	S/5 to 6 BOPH POP
7/17	NR
7/23	Spud 6-11-52 Oil Well TD 3891 8" @ 183 Anhy 1539 Heeb. 3502 Lans. 3546 Simp 3886 5" @ 3888 TD 3891 3/4 boph Hydro S/5-6 boph Comp. 50 bopd 25% wtr.

FORM 275 FOR SALE BY KANSAS BLUE PRINT CO


County Ellis State Kansas

Sec. 6 (Blk. Twp.) 14 (Sur. Rge.) 19W Map No.

Operator Brunson Drlg.

Well No. 2 Farm Irvin

Elev. Location SE SE NE

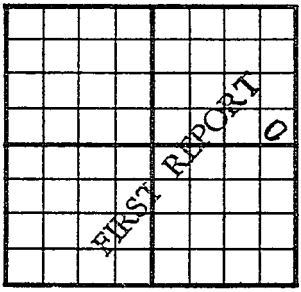

330 Ft. From S Line NE

330 Ft. From E Line Quarter

1st. Report JUN 11 1952

Completion

Remarks Brunson Drlg. - Contr.

Spudding Date Irvin Pool

Drlg. Data

Cellar & pits

J. G. McGEHEE

FORM 275 FOR SALE BY KANSAS BLUE PRINT CO.


County Ellis State Kansas

Sec. 6 (Blk. Twp.) 14 (Sur. Rge.) 19W Map No.

Operator Brunson Drlg.

Well No. 2 Farm Irvin

Elev. 2255 Location SE SE NE

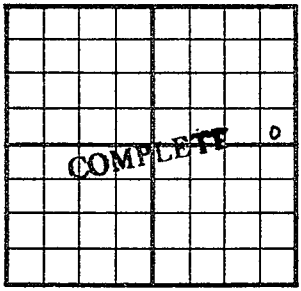

330 Ft. From S Line NE

330 Ft. From E Line Quarter

1st. Report

Completion JUL 3 1952

Remarks Irvin Pool

Brunson Drlg. - Contr.

Spudding Date 6-11-52

Drlg. Data Oil well TD 3891

8" @ 183 Anhy 1539 Heeb. 3502

Lans. 3546 Simp. 3886 5" @ 3888

TD 3891 3/4 boph Hydro. S/ 5-6 boph

Comp. 50 bopd 25% water

J. G. McGEHEE