


Section 27 Township 13 Range 14W  
Well No. 1 Peake  
Company Shields Oil Producers

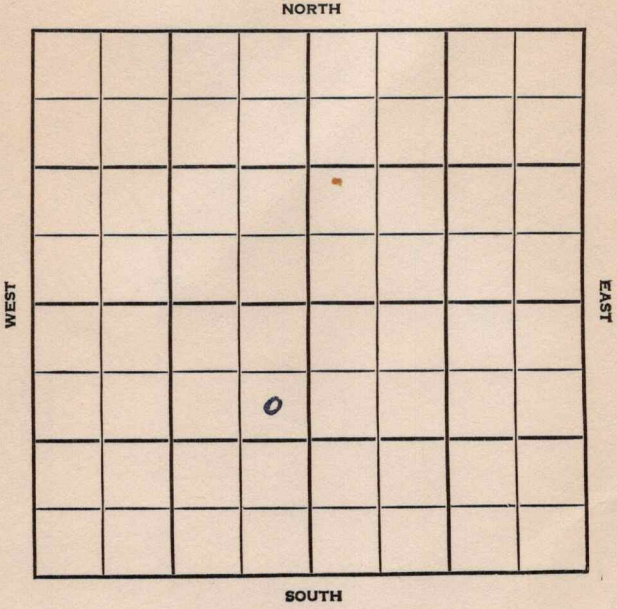

Russell

KANSAS

SEC.	TWP.	R.
27	13	14 W

WELL NO. # 1 Peake FARM  
 COMPANY

CONTRACTOR Shields Oil Producers


Co. tools  
 Russell Pool

990 Ft. from N. Line

Ft. from S. Line

330 Ft. from E. Line

Ft. from W. Line

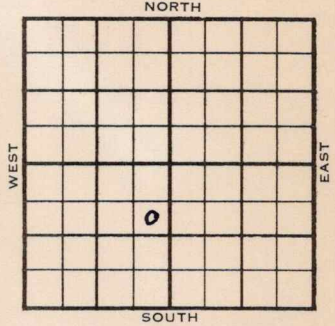

SE NE SW

	ELEVATION	REPORT
1955	1841'	
2/2	Cellar & Pits	
3/9	Spud 2-2-55 Oil Well TD 3264' 8" @ 184'	
	Anhy 865', KC 2992' Arb. 3262'	
	Heeb. 2934', Tor. 2953' Doug. 2968'	
	TD 3264' 5" @ 3263' CO to 3264 Comp 50 bopd.	
		COMPLETED

County **Russell** State **Kansas**

Sec. **27** (Blk. Twp.) **13** (Sur. Rge.) **14W** Map No.

Operator **Shields Oil Producers**

Well No. **1** Farm **Peake**

Elev. Location **SE NE SW**


**FIRST REPORT**

o

**990** Ft. From **N** Line **SW**

**330** Ft. From **E** Line Quarter

1st. Report **FEB 2 1955**

Completion

Remarks

**Co. tools**

Spudding Date

Drlg. Data **Russell Pool**

**Cellar & pits**

**FABEN GILSTRAP**

