

Ellis


KANSAS

SECTION 6 TOWNSHIP 14 RANGE 19W

WELL NO. #2 Irvin Unit

COMPANY Jack Spines, etal

NORTH

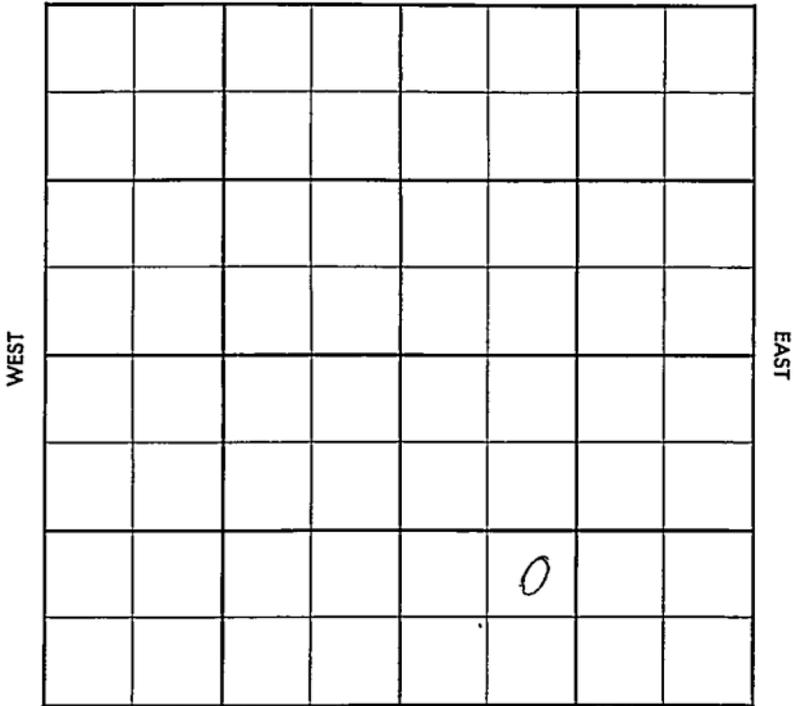

SOUTH

County Ellis Elev. 2270
 Sec. 6 Twp. 14 Rge. 19W
 Company Jack Spines, etal
 FarmName Irvin Unit No. 2

TOPS	DEPTH	LOG	DATUM	Loc. in Sec.
Anb.				NE SW SE
Tp.				
H.				
Tr.				
Dg.				
Bl.				
L.				Geol.
K.C.				Contr.
B.K.C.				Brunson Prod. &
Ce.				Expl. Tools
C.				Pool
M.				Irvin
M.				
K.				
Mz.				
Ma.				
V.				
S.				
S.				
A.				
R.				
PE.				
G.				
T.D.				

DEC 15 1956
 FIRST REPORT

Date Comm 12-15-56
8" @ 203 w/115, Drlg. 1840

~~14~~

County Ellis Elev. 2270
 Sec. 6 Twp. 11 Rge. 19W
 Company Jack Soines, etal
 Farm Name Irvin Unit No. 2

TOPS	DEPTH	LOG	DATUM	Loc. in Sec.
Anh.				NE SW SE
Hp.				
H.	3520			
Tr.	3545			
Dg.				
Bl.				
L.	3567			
K.C.				Geol.
B.K.C.	3808			Contr.
Ce.				
C.	3853			Brunson Prod. & Expl. Co. Inc.
M.				Pool
M.				Irvin
K.				
Mz.				
Mo.				
V.				
S.				
S.				
A.	3901			COMPLETE FEB 27 '57
R.				
PE.				
G.				
TD.	3906			

Date Comm. 12-15-56
8" @ 203 w/115, Drlg. 1840 DEC 26 '56
DIT 3901-06 90" rec 120' wtr
BHP 1125/20" 5 1/2 @ 3904 JAN 2 '57
CO 3906 @ 1 1/2 Bopd (1/2)
POP ~~1125~~ JAN 9 '57
1/2 @ 3906 JAN 30 '57 FEB 8 '57 P. 70 Bopd
no/wtr. FEB 13 '57 ✓ FEB 20 '57 FEB 27 '57
Ph P. 85 Bopd + 25' wtr