


Section 27 Township 13 Range 14 W

Well No. #1 Schulte

Company Kim Oil

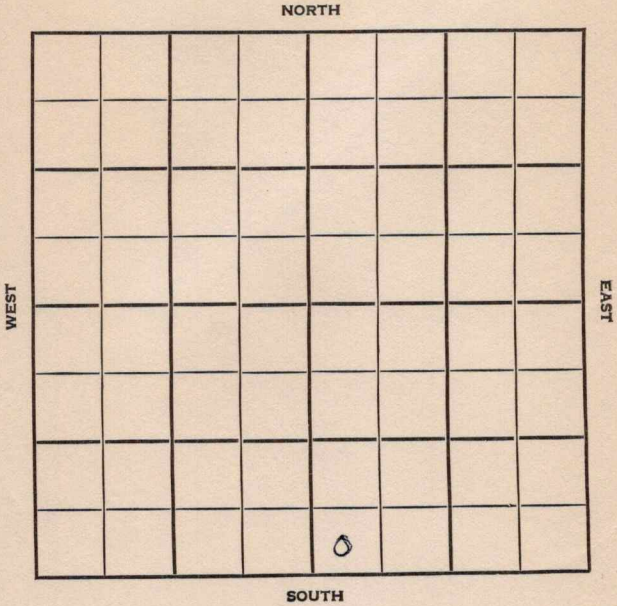

Russell

KANSAS

SEC. 27	TWP. 13	R. 14W
------------	------------	-----------

WELL NO.

#1 Schulte

FARM

COMPANY

Kim Oil

CONTRACTOR

Mast Drlg.

Russell


_____ Ft. from N. Line

_____ Ft. from S. Line

_____ Ft. from E. Line

_____ Ft. from W. Line

SW SW SE W¹/₂ Lots 2 & 3
Block 143

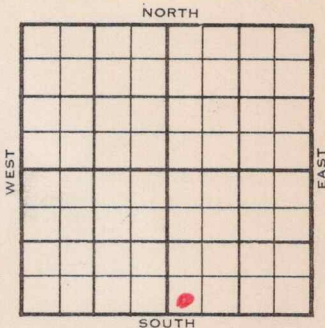

FIRST REPORT

	ELEVATION	REPORT
1955	1847	
8/3	MIR	
8/31	Comm 8-2-55	
	H	2948
	L	3008
	A	3276
	TD	3277
	8 5/8" @ 307	
	5 1/2" @ 3274 DD 3279	
	500 A S/12.8 bo 1/2 hr P/200 bopd	
	Comp 25 bopd	

COMPLETED

County Russell Elev. _____
 Sec. 27 Twp. 13 Rge. 14W
 Company Kim Oil
 Farm Name Schulte No. 1

TOPS	DEPTH	LOG	DATUM
Anh.			
TP.			
H.			
Tr.			
Dg.			
BL.			
L.			
K.C.			
B.K.C.			
Ce.			
C.			
M.			
M.			
K.			
Mz.			
Me.			
V.			
S.			
S.			
A.			
R.			
PE.			
G.			
T.D.			

Loc. in Sec. _____
SW SW SE
W¹/₂ Lots 2 & 3
Block 143
 Geol. _____
 Contr. _____
Mast Drlg.
 Pool _____
Russell

FIRST REPORT
AUG 3 '55
0

Date Comm. _____

M I R

13

Co.
Lse.
No.
Sec.
T.
R.

County Russell Elev. 1847
 Sec. 27 Twp. 13 Rge. 14W
 Company Kim Oil
 Farm Name Schulte No. 1

Co.

TOPS	DEPTH	LOG	DATUM	Loc. in Sec.
Anh.				SW SW SE
T.P.				
H.	2948		1101	
Tr.				
Dg.				
B.L.				
L.	3008		1161	Geol.
K.C.				Contr.
B.K.C.				Mast Drlg.
Ce.				Pool
C.				Russell
M.				<div style="border: 1px dashed black; padding: 10px; text-align: center;"> <p>COMPLETE</p> </div>
M.				
K.				
Mz.				
Me.				
V.				
S.				
S.				
A	3276		1429	
R.				
PE.				
G.				
T.D.	3277			0

Lse.

No.

Sec.

T.

R.

Date Comm. 8-2-55 AUG 3 1 1955

8 5/8" @ 307 5 1/2" @ 3274 DD 3279

500 A S/ 12.8 bo 1/2 hr. P/ 200 bopd

Comp. 25 bopd