


KANSAS

Russell

Sec. 27

Twp. 13

R. 14W

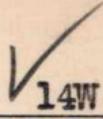

Well No. #7 Shaeffer Farm

Eldorado Ref. Company

Russell Pool

_____ Ft. from N. Line


330'

_____ Ft. from S. Line

_____ Ft. from E. Line

990'

_____ Ft. from W. Line

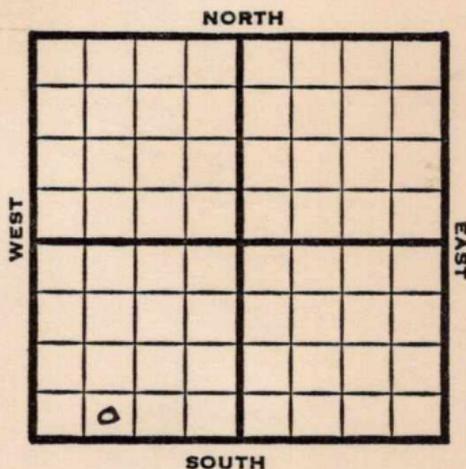

SE SW SW

1949

Lev 1853' REPORT

5/4

8" @ 359'

Anhy 880'

5/10

Drlg. 1150'

Lansing 3038'

Arb. 3284'-88'

TD 3288'

5" @ 3285'

5/18

TD 3290

2000' oil

18 hrs.

5/25

"

6/1

TD 3290'

Arb. 3284'

5" @ 3285'

Pump 75 Oil Pot

38° Gr.

Comp

COMPLETED

Kansas

Map No. _____ Sec. 27 Twp. 13 R. 14W

Well No. 7 Shaeffer

Eldorado Ref. Company _____

FIRST REPORT

Contractor _____

SE SW SW

SECTION PLAT

_____ Ft. from N. Line

330 Ft. from S. Line

_____ Ft. from E. Line

990 Ft. from W. Line

Russell County

Location _____

Rig up _____

Drilling and Remarks:

8" @ 359

Anhy 880

drlg. 1150

RECORD

Cased _____ in., _____ ft.

Sand _____

Gas _____

Oil _____

Total Depth _____

PRODUCTION

1st 24 hrs. Nat. _____

1st 24 hrs. after shot _____

Gas _____ Cu. Ft.

Dry Hole _____

Abandoned _____

Date

MAY 4 1949

19

S. J. LEWIS

Scout

