


Ellis

KANSAS

Section 6 Township 14 Range 19WWell No. #2 Mae SchwallerCompany Stanolind Oil and Gas Company

NORTH

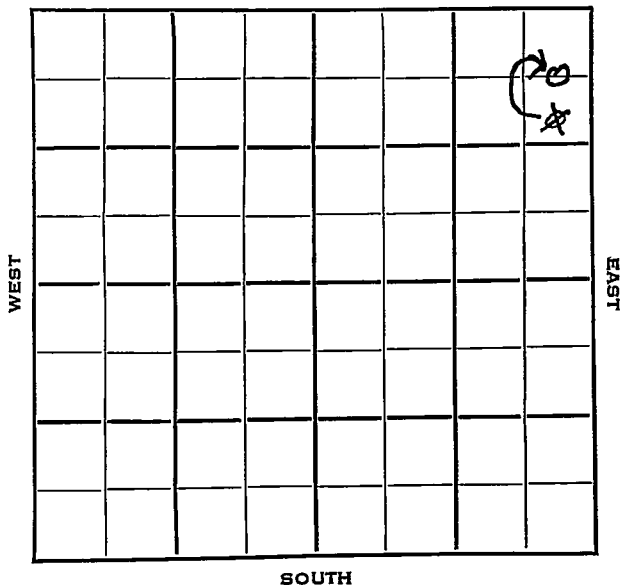

Ellis

Sec. 6 Twp. 14 R. 19WWell No. #2 Mae Schwaller FarmStanolind Oil and Gas Company Company


Contractor

660
990 Ft. from N. Line

Ft. from S. Line

330 Ft. from E. Line

Ft. from W. Line

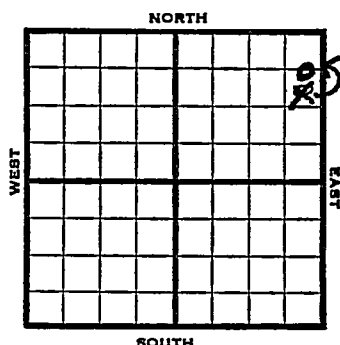~~C E L NENE~~~~SE NE NE~~

1953 Elev. 2273' REPORT

3/4 Location

3/12 8" @ 160

Drlg. 2910'

3/19 Lans 3553'

DST 3583-95, 20 mins, 780' SW 1600#

DST 3726-41, 20 mins, 120' MCO 1215#

Arb. 3887'

DST 3886-96, 1/2 hr, 125' oil, 150' MCO
1010# RTD 3896' Schl

3/26 5" @ 3889

CO 3896

S/5 1/2 boph 8 hrs.

C 3896-99 TD sdy dol 500A

4/1 Spud 3-4-53

Oil Well

TD 3899

8" @ 160

Lans 3553,

DST 3583-95 open 20 mins. Rec 780' sw
1600#DST 3726-41 open 20 min. Rec 120' mco
1215#

Arb 3887

DST 3886-96 open 1/2 hr. Rec 125' oil
150' mco 1010#

OVER

County Ellis State Kansas

Sec. 6 (Blk. Twp.) 14 (Sur. Rge.) 19W Map No.

Operator Stanolind

Well No. 2 Farm Mae Schwallier

Elev.	Location	SE	NE	NE
-------	----------	----	----	----

0

END OF REPORT

990Ft. From N Line NE

330 Ft. From E Line Quarter

1st. ReportMAR 4 1953

Completion

Remarks

Spudding Date

Drlg. Data

Location

Map No. _____ Sec. 6 Twp. 14 R. 19WWell No. 2 Mae SchwallerStanolind

Company

CORRECTION

Contractor

C E L N E N E

SECTION PLAT

660

Ft. from N. Line

Ft. from S. Line

330

Ft. from E. Line

Ft. from W. Line

		X		o

Ellis County

Location _____

Rig up _____

Drilling and Remarks:

Reported
SE NE NE

RECORD

Cased _____ in., _____ ft.

Sand _____

Gas _____

Oil _____

Total Depth _____

PRODUCTION

1st 24 hrs. Nat. _____

1st 24 hrs. after shot _____

Gas _____ Cu. Ft.

Dry Hole _____

Abandoned _____

Date

MAR


4 1953

19

J. G. McGEHEE

Scout

County Ellis State Kansas
 Sec. 6 (Blk.) 14 (Sur.) 19W Map No.
 Operator Stanolind
 Well No. 2 Farm Mae Schwaller
 Elev. 2273 Location C E L NE NE

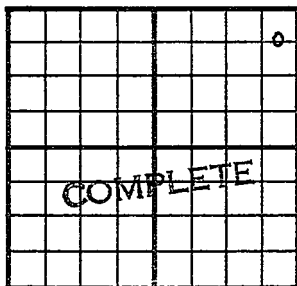

660 Ft. From N Line NE
 330 Ft. From E Line Quarter

Ist. Report

Completion APR 1 1952

Remarks

Spudding Date 3-4-53

Drlg. Data Oil well TD 3899

8" @ 160 Lans. 3553 DST 3583-95

open 20 min. Rec. 780' sw 1600#

DST 3726-41 open 20 min. Rec. 120' mco

1215# Arb. 3887 DST 3886-96 open $\frac{1}{2}$ hr.

Rec. 125' oil 150' mco 1010# TD 3896

5" @ 3889 CO to 3896 S/ $5\frac{1}{2}$ boph 8 hr.

TD 3899 500 A S/ 20 boph 3 hr.

dec. to 13 boph Comp. 164 bopd

1953

Information brought forward

4/1

TD 3896,

5" @ 3889'

CO to 3896

S/ $5\frac{1}{2}$ boph 8 hr.

TD 3899

500 A S/ 20 boph 3 hr.

dec. to 13 boph

Comp. 164 bopd

COMPLETED