


Section 6 Township 14 Range 19W

Well No. #1 Reidel "C"

Company Stanolind Oil and Gas Company

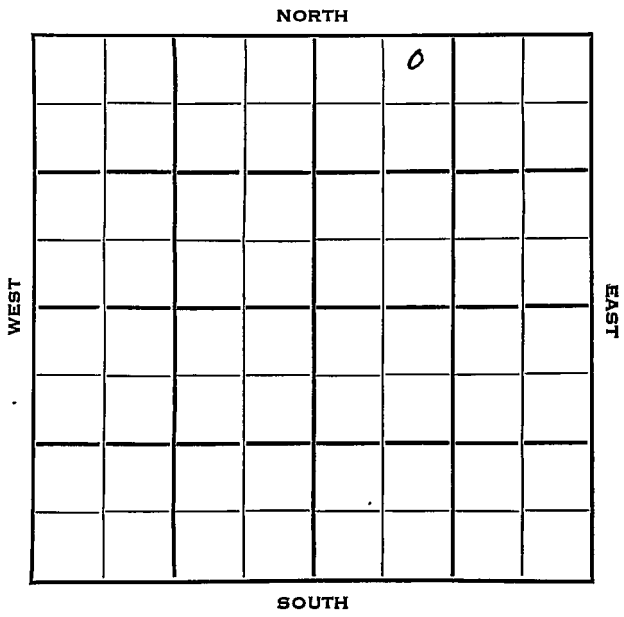

Sec. \_\_\_\_\_ Twp. \_\_\_\_\_ R. \_\_\_\_\_

#1 Reidel "C"

Well No. \_\_\_\_\_ Farm \_\_\_\_\_

Stanolind

Company \_\_\_\_\_

N. Irvin Pool

Contractor \_\_\_\_\_

330

Ft. from N. Line


Ft. from S. Line

Ft. from E. Line

990

Ft. from W. Line

NE NW NE

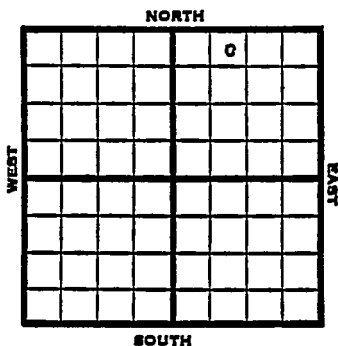

1953

Elev. 2284' REPORT

1/28  
2/5

Location  
8" @ 170  
Drlg. 1800'

2/12

Lans. 3566'  
DST 3596-3605, 1/2 hr, 445' SW, 30'  
GCM. Drlg.

2/19

DST 3737-51, 1/2 hr, 70' OCM 270#  
Arb. 3906  
DST 3902-11, 1/2 hr, 25' oil, 120'  
MCO. 1075# RTD 3912 7" @ 3908

2/26

CO 3912' S/4 1/2 BO 12 hrs 500 A  
S/16 1/4 BOPH 4 hrs, 2000' off btm.  
S/10 BOPH 4 hrs.

3/4

Spud 1-30-53  
Oil Well  
TD 3912  
8" @ 170  
Lans 3566  
DST 3596-3605, opn 1/2 hr., rec.  
445' sw, 30' gcm,  
DST 3737-51; opn 1/2 hr., rec.  
70' ocm, 270#  
Arb 3906  
DST 3902-11, opn 1/2 hr., rec. 25'  
oil, 120' mco, 1075#  
TD 3912  
7" @ 3908, CO to 3912  
S/4 1/2 bo 12 hrs., 500A S/16 1/4 bop  
h 4 hrs. S/10 bopd 4 hrs. OVER

County Ellis State Kansas

Sec. 6 (Blk. 14) (Sur. Rge.) 19W Map No.

Operator Stanolind

Well No. 1 Farm Reidel "C"

Elev. \_\_\_\_\_ Location NE NW NE


330 Ft. From N Line NE

990 Ft. From W Line Quarter

Ist. Report JAN 28 1953

Completion \_\_\_\_\_

Remarks \_\_\_\_\_

Spudding Date \_\_\_\_\_

Drlg. Data N. Irvin Pool

Location


County Ellis State Kansas

Sec. 6 (Blk. Twp.) 14 (Sur. Rge.) 19W Map No.

Operator Stanolind

Well No. 1 Farm Reidel "C"

Elev. 2284 Location NE NW NE

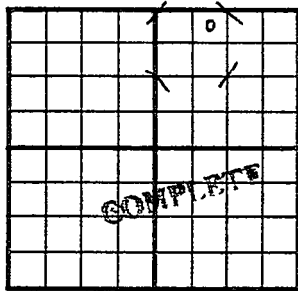

330 Ft. From N Line NE

990 Ft. From W Line Quarter

1st. Report

Completion MAR 4 1953

Remarks N. Irvin Pool

Spudding Date 1-30-53

Drig. Data Oil well TD 3912

8" @ 170 Lans. 3566 DST 3596-3605

open 1/2 hr. Rec. 445' sw 30' gcm

DST 3737-51 open 1/2 hr. Rec. 70' ocm

270# Arb. 3906 DST 3902-11 open 1/2 hr.

Rec. 25' oil 120' mco 1075# TD 3912

7" @ 3908 CO to 3912 S/ 4 1/2 bo. 12 hr.

500 A S/ 16 1/4 boph 4 hr. S/ 10' boph

4 hr. Comp. 1030 bopd

#1 Reidel "C"  
(Information Brought Forward)

1953  
3/4

Comp. 1030 bopd

**COMPLETED**