


Section 7 Township 14 Range 19 W

Well No. # 1 Kramer

Company Rocket Drlg.

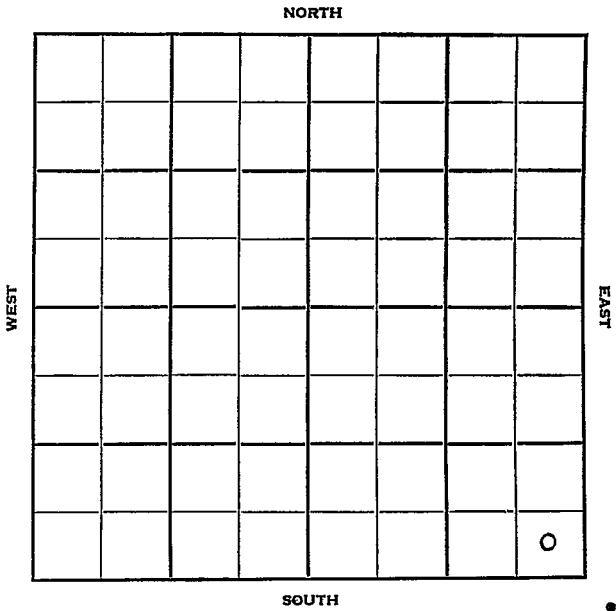

Ellis

KANSAS

Sec. 7 Twp. 14 R. 19W

Well No. #1 Kramer Farm ✓

Rocket Drlg.

Company

Wildcat

Contractor

Ft. from N. Line

330'


Ft. from S. Line

330'

Ft. from E. Line

Ft. from W. Line

SE SE SE

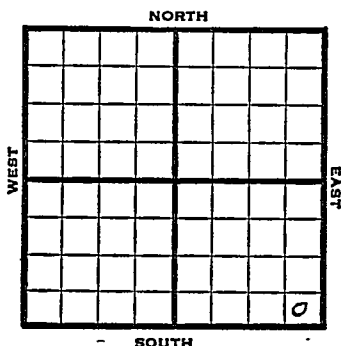

1951

Elev. 2216'

REPORT

9/26

Drlg.

11/28

Spud 9-21-51

D&A TD 3866

8" @ 198

Anhy 1180 Ians. 3516

Cong. 3801 Arb. 3830

DST 3827-32 open 1 hr.

Rec. 45' OCM

DST 3839-41 open 1 hr.

Rec. 40' gas 95' mud & oil

TD 3841 5" @ 3834

CO to 3841 B/ 1BOPH 500 A

S/ 2 BOPH 1000 A P/ $\frac{1}{4}$ BO

$\frac{1}{2}$ BWPH 1000 A S/ 1 BFPH

DD 3866 PB 3834

24/ 3826-33 S/ 30 GFPH

D&A

ABANDONED

County **Ellis** State **Kansas**

Sec. **7** (Blk.) **14** (Sur.) **19W** Map No.

Operator **Rocket Drig.**

Well No. 1 Farm Kramer

Elev.	2216	Location	SE SE SE
-------	------	----------	----------

FIRST REPORT

330 Ft. From S Line SE

330 Ft. From E Line Quarter

1st. Report SEP 26 1951

Completion


Remarks

Spudding Date _____

Drlg. Data Wildcat

drig.

J. E. TYRA

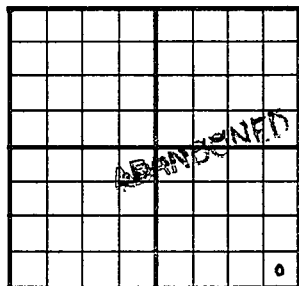County Ellis State KansasSec. 7 (Blk.
Twp.) 14 (Sur.
Rge.) 19W Map No.Operator Rocket Drlg.Well No. 1 Farm KramerElev. 2216 Location SE SE SE330 Ft. From S Line SE330 Ft. From E Line Quarter

1st. Report

Completion NOV 28 1951Remarks WildcatSpudding Date 9-21-51Drlg. Data D & A TD 38668" @ 198 Anhy 1180 Lans. 3516Cong. 3801 Arb. 3830 DST 3827-32open 1 hr. Rec. 45' ocm DST 3839-41open 1 hr. Rec. 40' gas 95' mud & oilTD 3841 5" @ 3834 CO to 3841B/ 1 boph 500 A S/ 2 boph 1000 AP/ $\frac{1}{4}$ bo $\frac{1}{2}$ bwph 1000 A S/ 1 bfphDD 3866 PB 3834 24/ 3826-33S/ 30 gfphD & A

J. E. TYRA